Jany 24-1889

168. Lee 25/100 N. from point in N. line Main
N. E. side alley. N. 2
164.65 ft N. from W. line Main St. N. E. line
of alley.
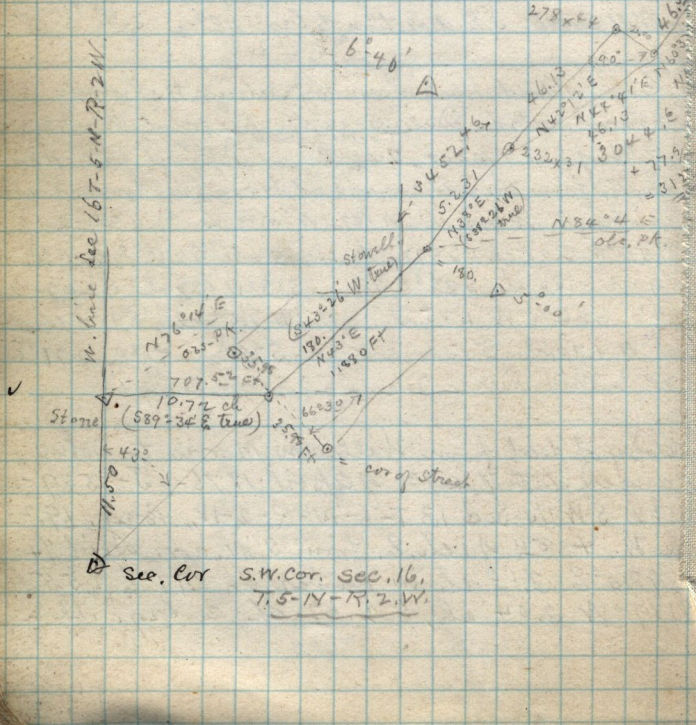
County Road from Hooper to Ogden City.