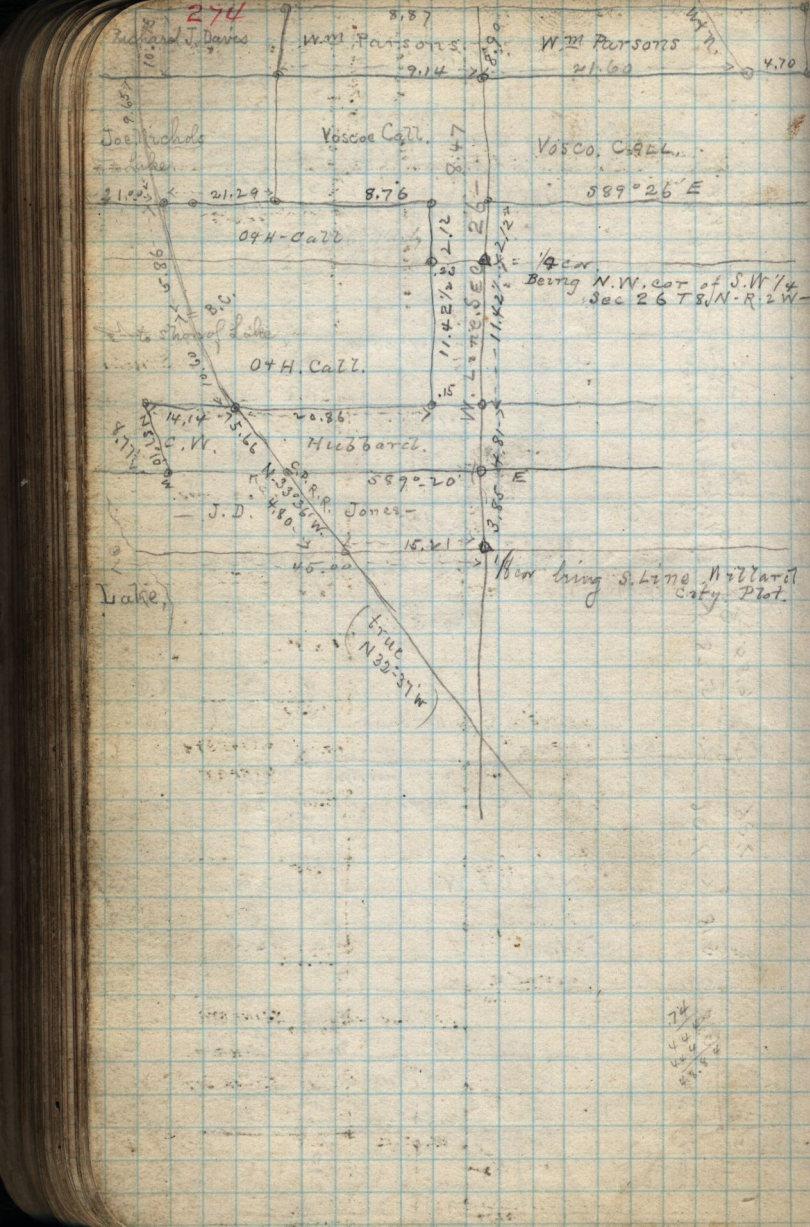
Richard J. Davis
Wm Parsons
Wm Parsons
Joe Nichols
Lake
Vosco Call.
Vosco. Call.
S89°26' E
21.29
8.76
21.60
4.70
8.87
9.14
8.47
2.12
2.12
1/4 cor
Being N.W. cor of S.W 1/4 Sec 26 T8N-R2W-
11.42
11.42
S 0°34' E
O4H-Call
O4H. Call.
Shingle Lake
B.C.
14.14
20.86
C.W.
Hubbard.
S89°20' E
J.D. Jones
15.21
1/4 cor being S. Line Willard City Plat.
Lake.
true N32°37'W