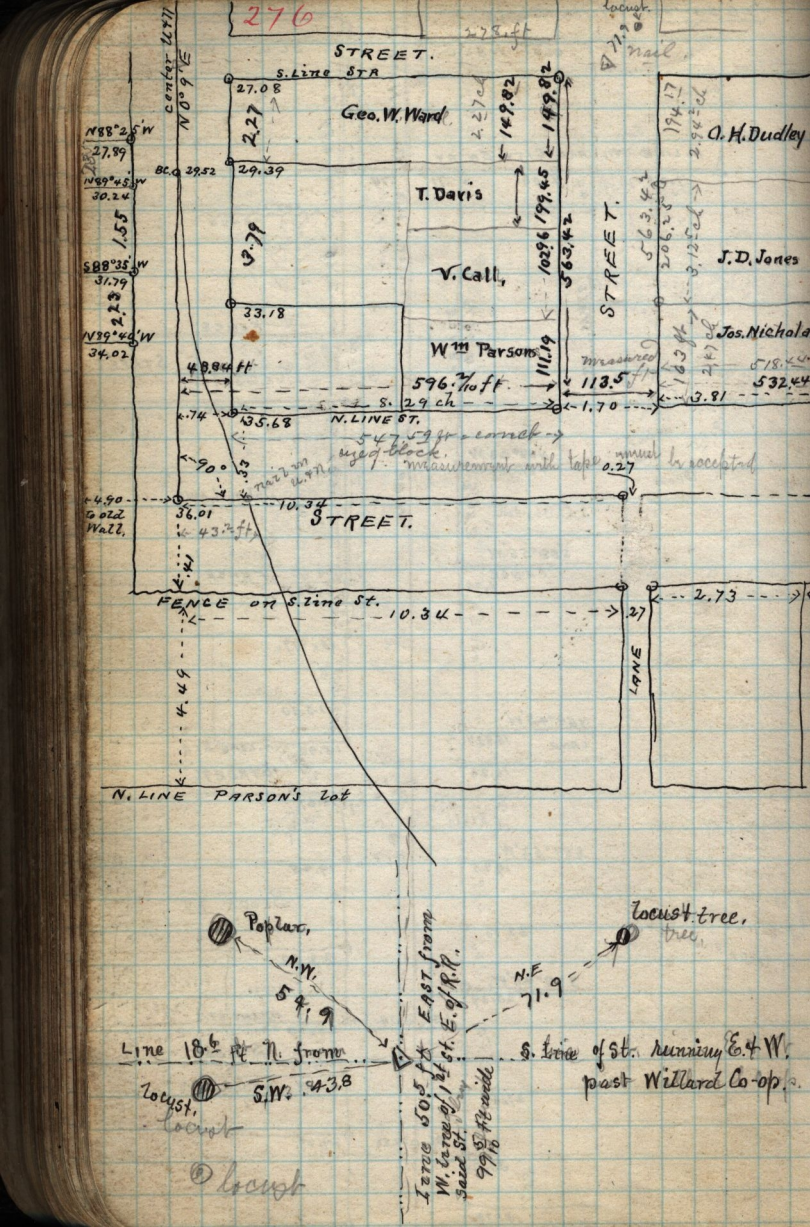
276
STREET.
S. Line STR
27.08
Geo. W. Ward
2.27
N88°2.5'W
27.89
N89°45'W
30.24
1.55
S88°35'W
31.79
2.23
N39°46'W
34.02
29.52
29.39
T. Davis
V. Call,
33.18
Wm Parsons
48.84 ft
596 7/10 ft
135.68
N. LINE ST.
S. 29 ch
1.74
90°
4.90
to old Wall
36.01
43.2 ft
STREET.
FENCE on S. line St.
10.34
4.49
N. LINE PARSON'S Lot
363.42
STREET.
O. H. Dudley
J. D. Jones
Jos. Nichola
113.5
1.70
532.44
518.
3.81
measured
0.27
2.73
LANE
Poplar,
N.W.
54 1/2
Locust tree,
N.E
71.9
Line 18.6 ft N. from
S.W. 43.8
Locust,
S. line of St. running E. & W.
past Willard Co-op.
Locust
Locust