


279

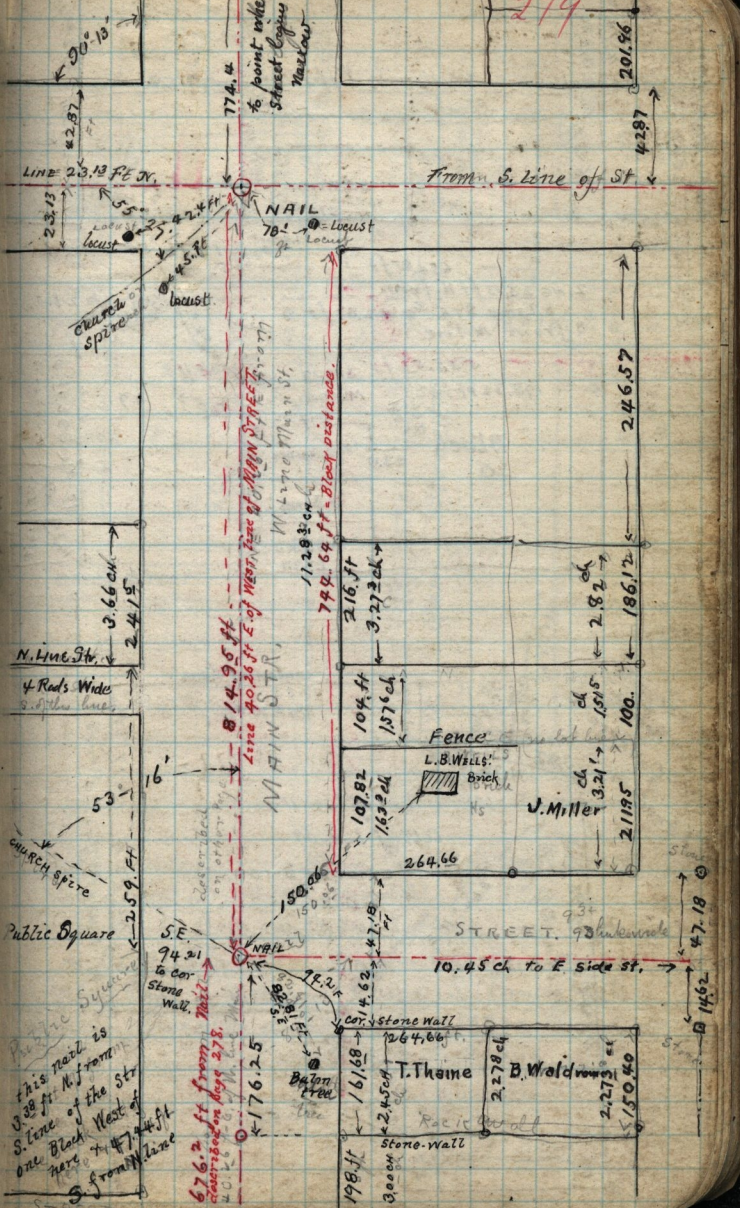

LINE 23.13 FE N.

From S. Line of St

NAIL 70° - Least

Church Spire

N. Line Str.

4 Rods Wide
S. of this line

Church Spire

Public Square

S.E. 94.21 to Cor Stone Wall

MAIN STREET

Line 40.36 ft E. of West Line of MAIN STREET

11.20 ch


Fence

L.B. Wells' Brick

J. Miller

STREET

10.45 ch to E. side st.

T. Thome

B. Waldron

this nail is 3.38 ft N. from S. Line of the Str. one Block West of here 747.4 ft from Lane

676.2 ft from Nail measured on days 278

Stone 47.18

Stone 1462

Stone

201.96

4287

246.57

216 ft

3.273 ch

104 ft

1376 ch

107.82

163.24

264.66

2.82 ch

151.5 ch

3.21 ch

186.12

211.95

161.68

2.45 ch

198 ft

300 ch

2.278 ch

2.27

150.40

Stone Wall

Cor. Stone Wall

264.66

Racine Wall



