


Copy of land for a deed from Pasmus Christensen to Peter Nordquist dated Feb-8-1889 as follows
 ✓ Part of N. E. 1/4 Sec. 17-T. 6-N-R-1-W, Brg.
 15 Rods N. of Bingham Fort Street on the side of Harrisville Co. Road. W 7 1/2 Rods S. 5 Rods E. 8 1/2 Rods N. W. to beg.

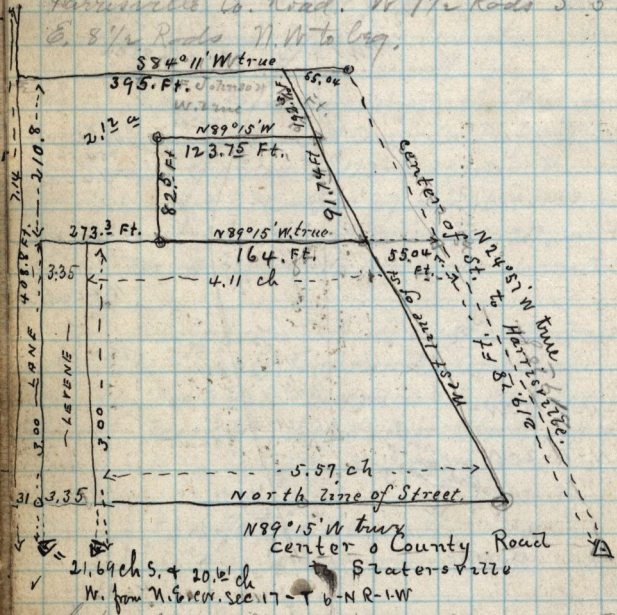

Copy of deed from Thomas Gibbons to Peter Lowe and Margaret Lowe, dated July 31-1882-

P-564- Beg 17 Rods S. from S. Line of 8th St. E 10 Rods + 9 ft. South 5-Rods, W 10 R + 12 ft N. S. R. to beg. Brg. also 1 Rod E. from N. line of Spring St.

Copy of deed from Chauncy Hadlock to Peter Lowe dated 31st May-1877- Recorded P-565-

Brg; 6.54 ch S. + 25 of 1 ch E. from N. E. cor Lot 6. B. H. S. D. S. E. S. R. S. W. R. N. S. R. N. W. R. to beg.

✓