


292

March 16-1889-

Survey for Leora Furness
in N.E. 1/4 Sec. 5 T-5 N-R-1-W.

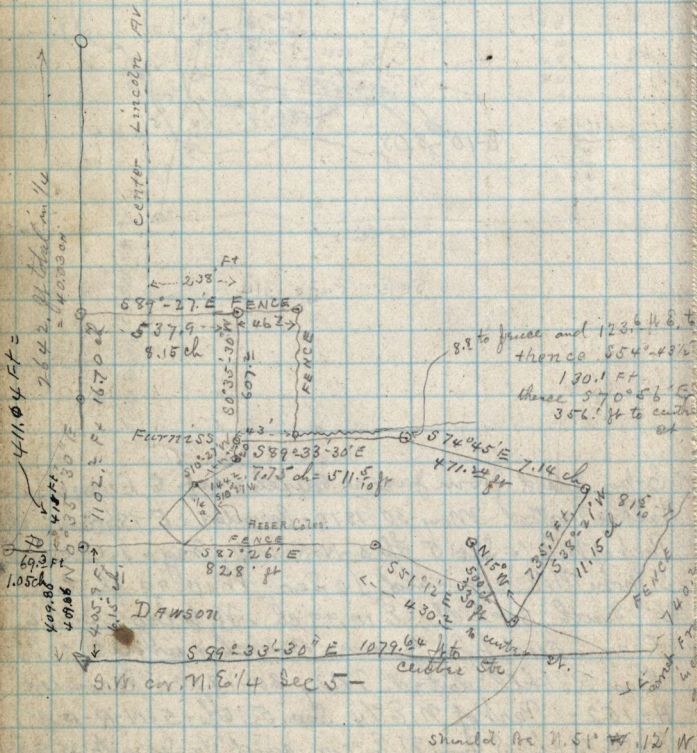

Note - from Furness, 366.4 ft N 39° 21' E true to County Survey Monument M 48 -