29.4

March 18-1889

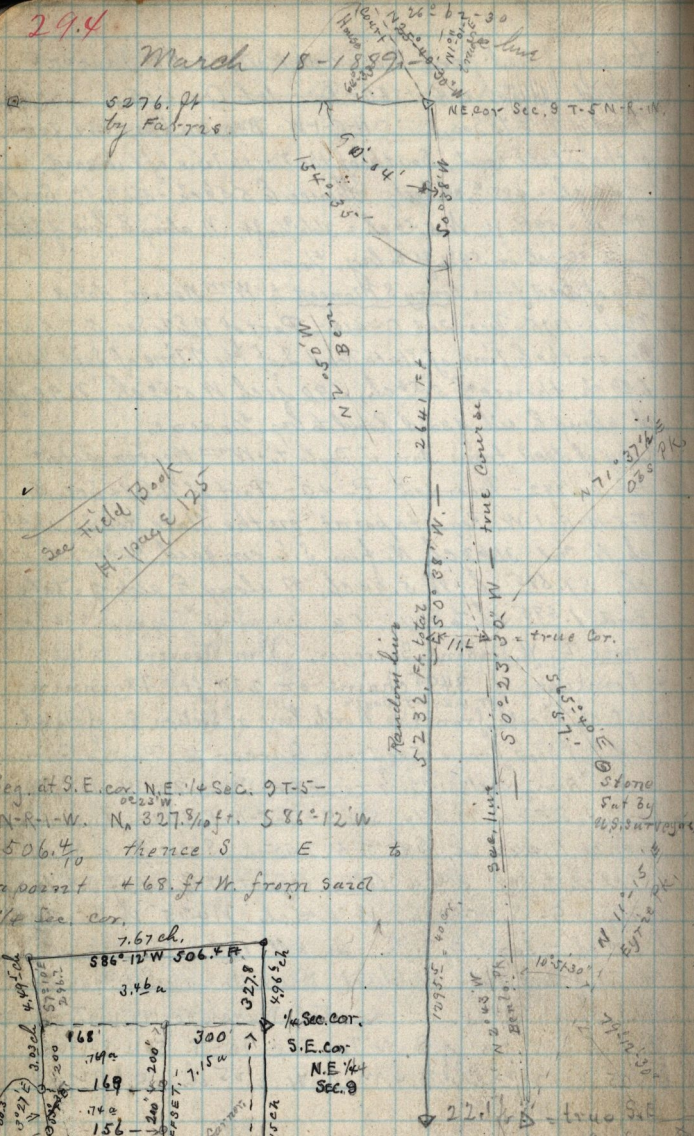
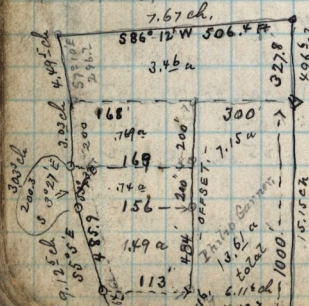
Beg. at S.E. cor. N.E. 1/4 Sec. 9 T-5-N-R-1-W. N 0° 23' W 327.8/10 ft. S 86° 12' W 506.4/10 thence S E to a point 468. ft W. from said 1/4 Sec. cor.