


old Iron Road 2' long in Center of County Road.

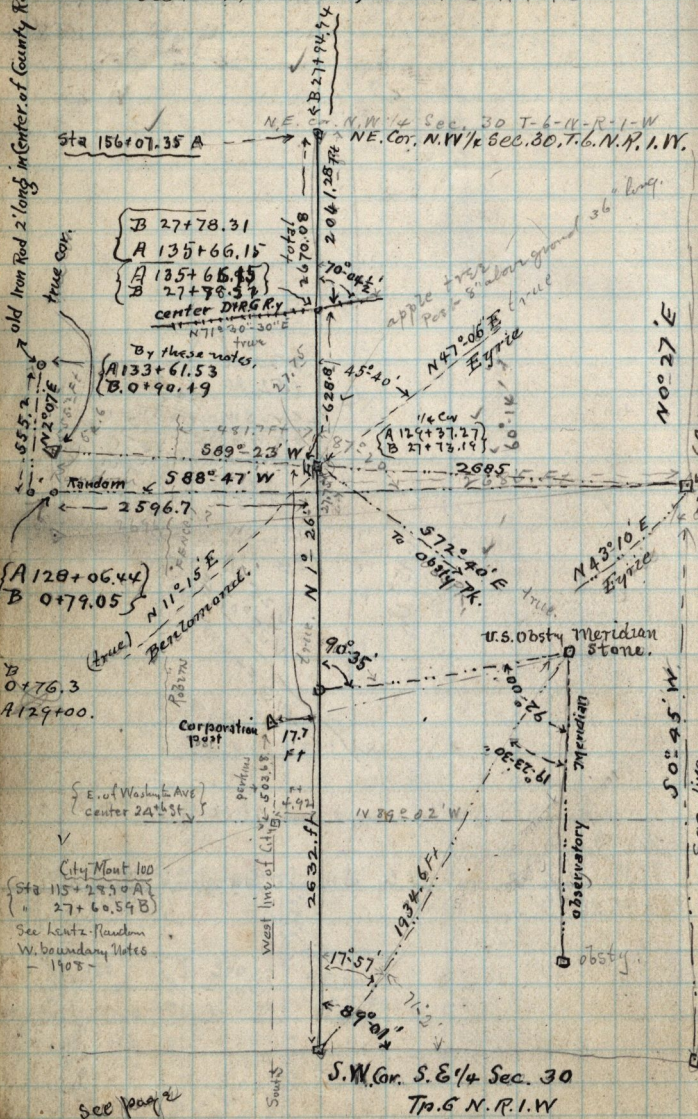

see page 236