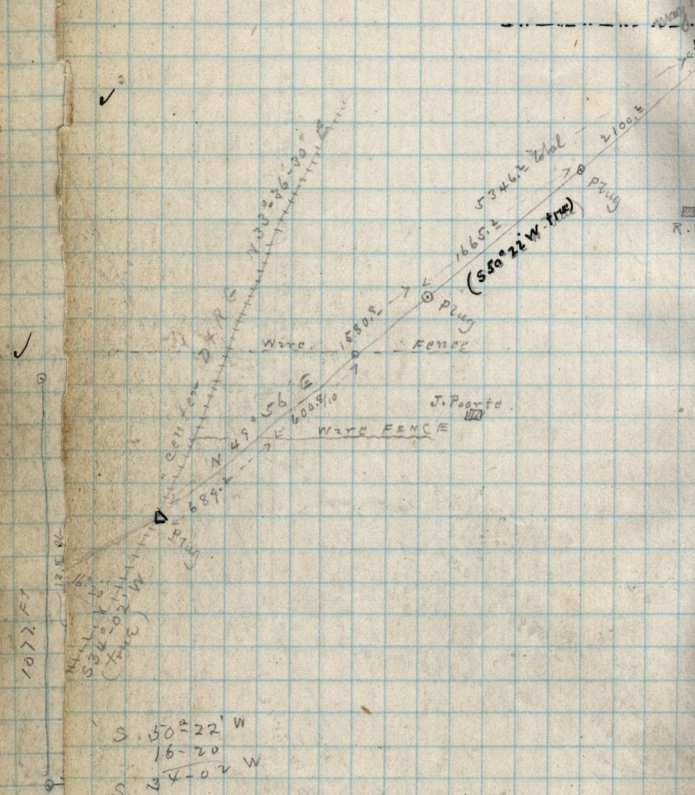

Center D & R G
N 33°36'30" E
N 49°56' E
689.2
600.8/10
1580.8
1665.2
5346.2 total
2100.2
(S50°22' W true)
Plug
Plug
Plug
Wire Fence
Wire FENCE
J. Poorte
1077 Ft
S34°02' W
(True)
S. 50°22' W
16-20
S 34-02 W