APRIL - 6 - 1889

Survey of Sections 10-9-2-T. 5. N-R 2-W.
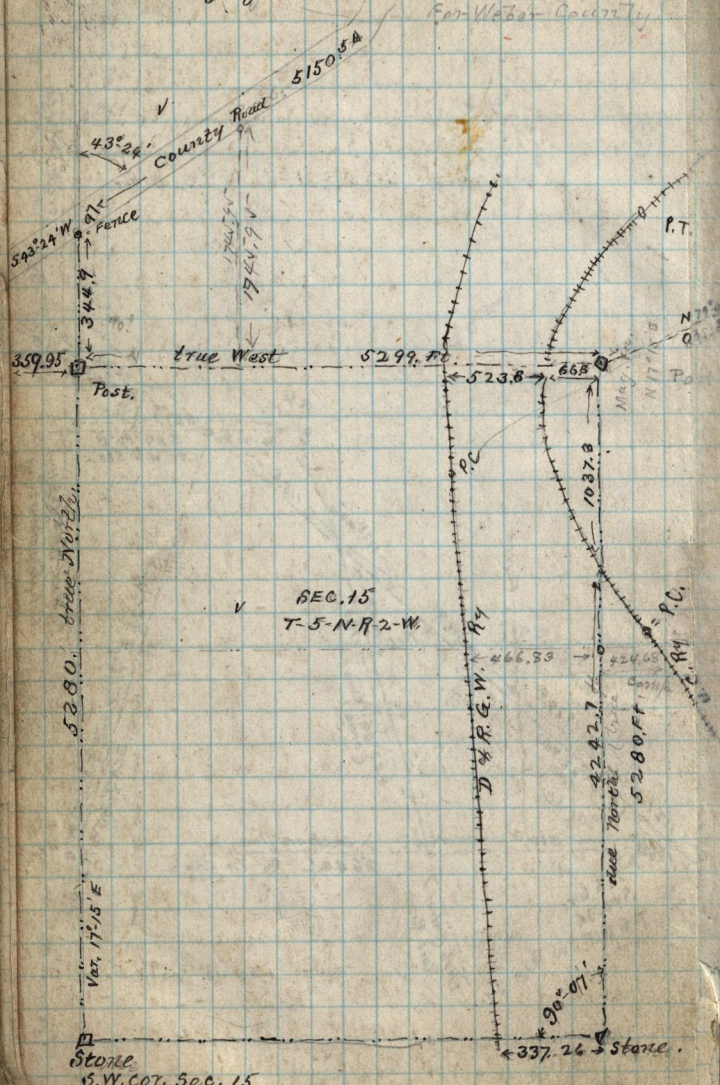
For Weber County Ty.