307

APRIL 8th 1889.
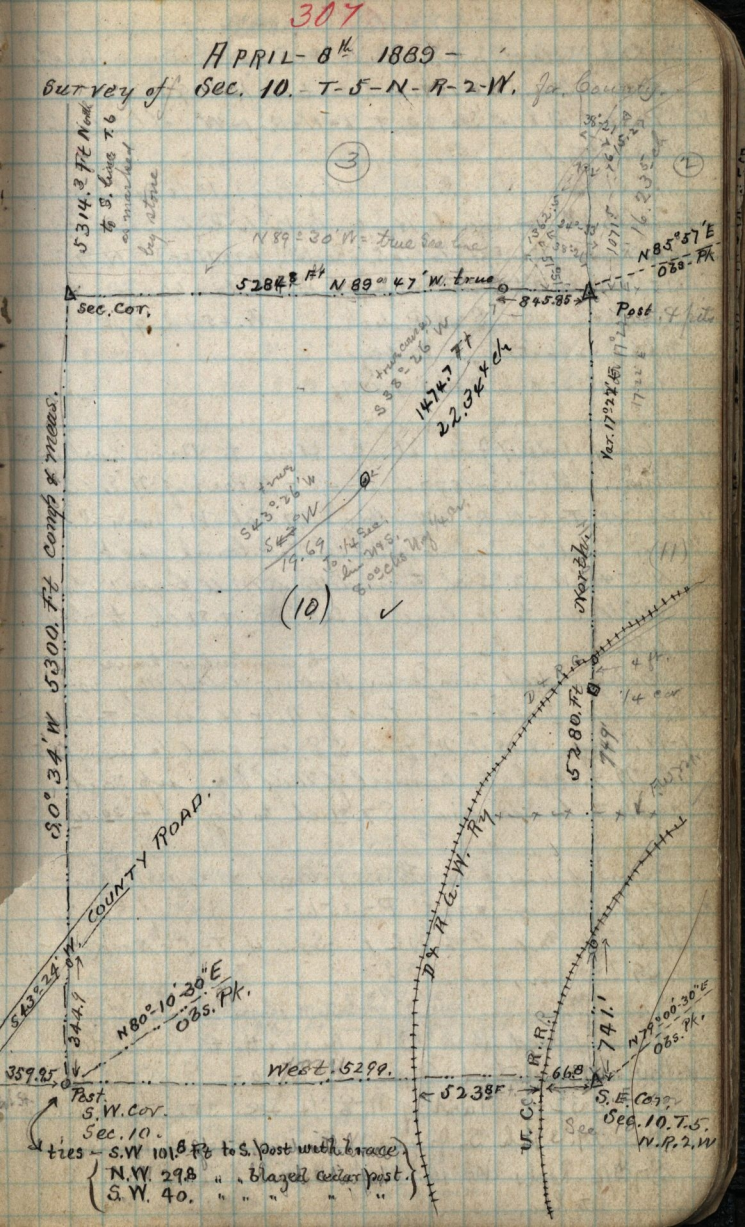
Survey of Sec. 10. T-5-N-R-2-W. Jo. County.