— APRIL 10-1889 — 309

Survey of Part of S.W 1/4 Sec. 35 - T-6-N-R-2-W for Ed Sewell & J. D. Stone. Beg. at S.W. cor said 1/4 Sec. Var 16°-48' E, Stone 12"x14"x14" marks S.W. cor. said 1/4 Sec. N 2661.5 ft to 1/4 cor. E. on Right angle 2645.5 ft to old established cor. Oak Stake

Copy of deed from Nahum Porter to Thomas D. Dee dated March 20-1875 L-9- Part of S.W. & S.E 1/4 Sec 17 T-6-N-R-1-W. Beg. at a point 19.55 ch South and 1.80 ch W. from N.E. cor of S.W 1/4 said Sec. E. 7.13 ch N. 5.00 ch W. 7.13 ch S. 5.00 ch to beg. 3.55 a.

Copy of deed from Fredrick A. Miller to John Folkers dated Nov 16-1869- E-30 — Part of S.E 1/4 Sec 17 T-6-N-R-1-W. Beg 46 1/2 Rods N. from S.W. cor. S.E 1/4 said Sec. N 36 1/2 Rods E 51 Rods S 20. Rods W 19 1/2 Rods S 16 1/2 Rods W 31 1/2 Rods to beg.

S.W 1/4 Sec. 17 T-6-N-R-1-W is 2657 ft on East line.

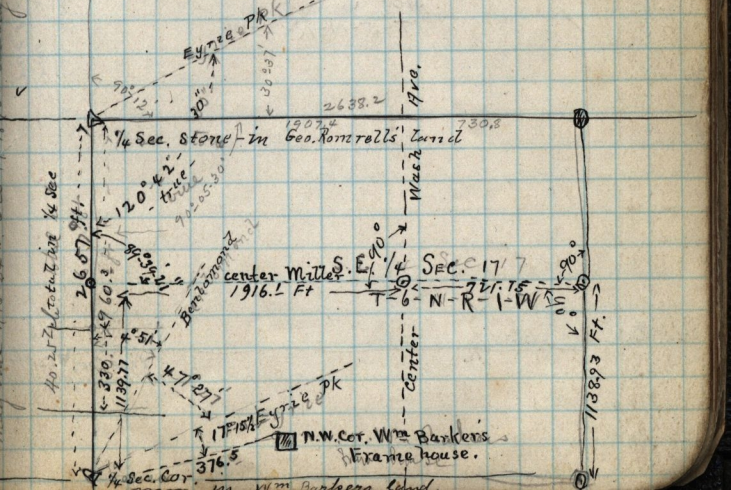
Eyetie Pk
30.1
2638.2
Ave.
1/4 Sec. Stone in Geo. Konrells' Lane
1907.4
730.8
Wash
120° 42'
17.42
90°25.30
90°35.21
2660.9 ft.
N.
Benchmark
center Miller
1916.1 Ft
S.E 1/4 SEC. 17
T-6-N-R-1-W
90°
90°
90°