May 1st 1889
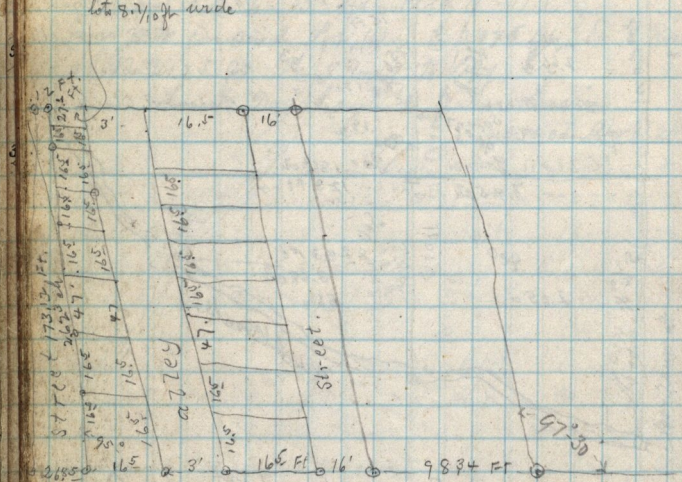
Survey of North Ogden Cemetery