



330

Copy of Patent from the U. S. to
Soren Petersen, Certificate No 1298
dated May 20th 1875 - not recorded
✓ June 7-1889 - for S 1/4 N. E 1/4 & the N. 1/4
of S. E. 1/4 of Sec 13 T-6-N-R-1-E, 160. ac.

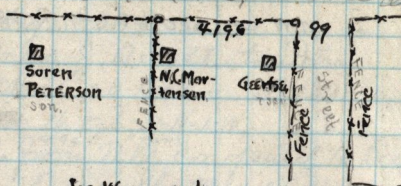

145 ft S. to ctr. 12th st.

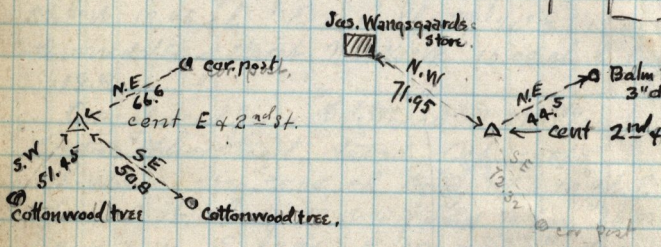

H