


June 7th 1889

331

Huntsville Survey

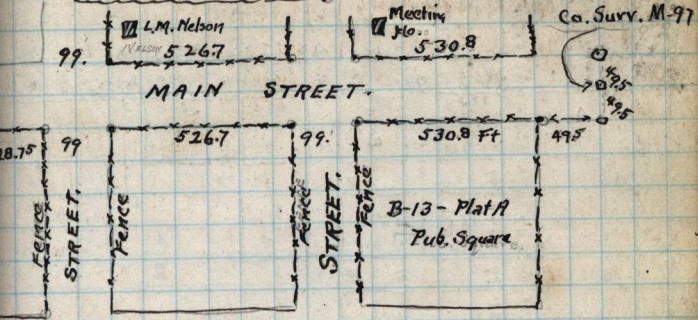

W

"D"