


332

145 fts to elev. 1245 ft

PRELIMINARY SURVEY of Hummerville
June 7-8-1889

SEMPLOYMENT 712 6 53
1/4 Sec Rock
1/2

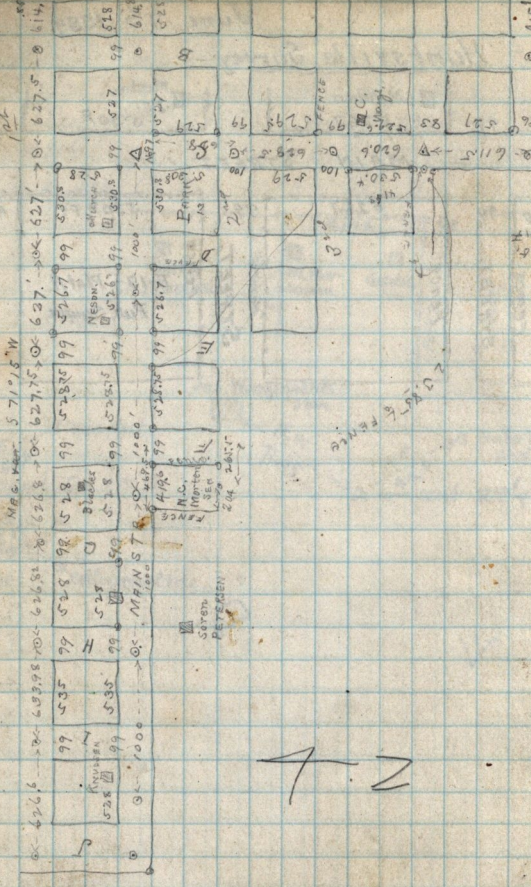

260
204
464
495
420.0