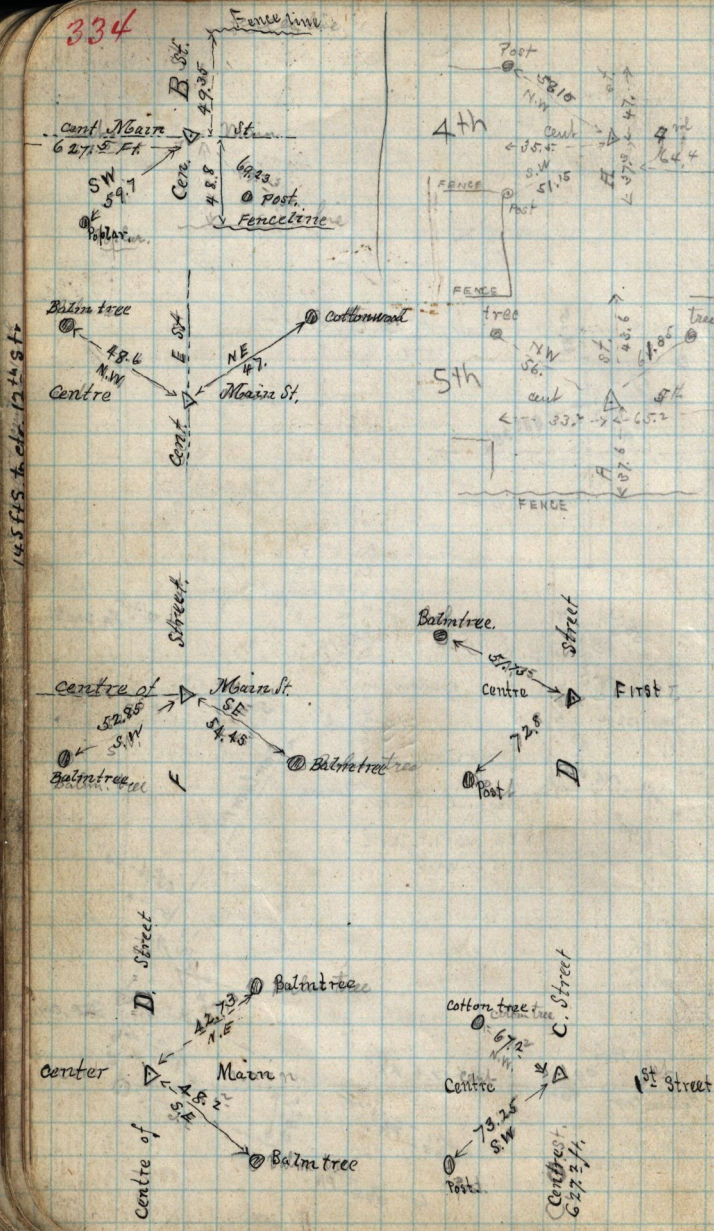
Fence line
B St.
49.35
Cent Main
627.5 Ft.
St.
SW
59.7
Poplar
Cen.
48.8
69.23
Post.
Fenceline
Post
58.10
N.W
4th
Cent
35.5
S.W
51.15
FENCE
Post
FENCE
tree
N.W
56.
5th
cent
33.2
65.2
FENCE
Balm tree
48.6
N.W
Centre
E St
NE
47.
Main St.
Cottonwood
Cent.
145 ft S to ctr. 12th St
Street
centre of
Main St.
52.85
S.W
Balmtree
SE
54.45
Balmtree
F
Balmtree.
Street
Centre
First
72.8
Post
D
D. Street
Balmtree
42.73
N.E
center
Main
48.2
S.E
Balm tree
Centre of
Cotton tree
C. Street
67.2
N.W.
Centre
1st Street
73.25
S.W
Post
Centre st.
627.2 ft.