145 ft S. to ctr. 12th St.

— Surveys in Huntsville —

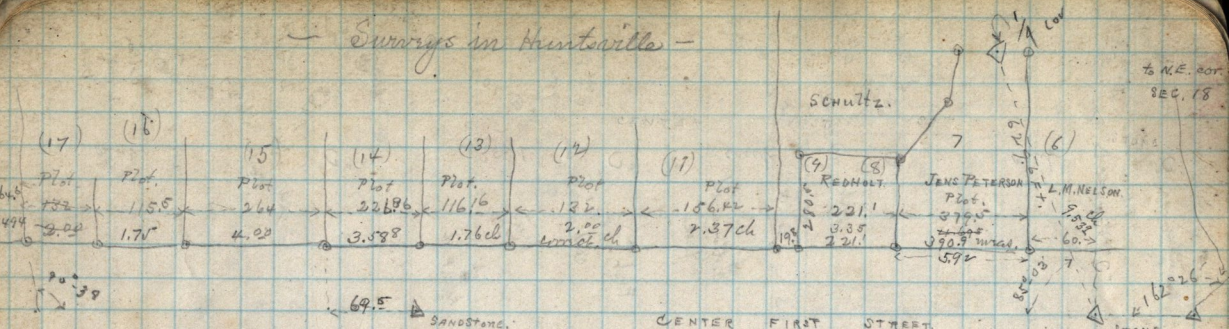

338