

342



2546.55

~~2547.05~~ FF

N.W. cor. SEC. 18 T-6-N-R-2-E

RANDOM LINE WEST

38.382 ch

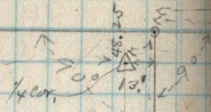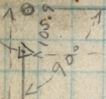

offsets & distances

Randomly - South - 2758.75 FF total


2652.85 = 40.195' ch

True line = S. 0° 12' 34" W. 2652.87 ft

True line from N 0° 08' 27" W. 2666.64

2705.75 FF on Random line NORTH

1169

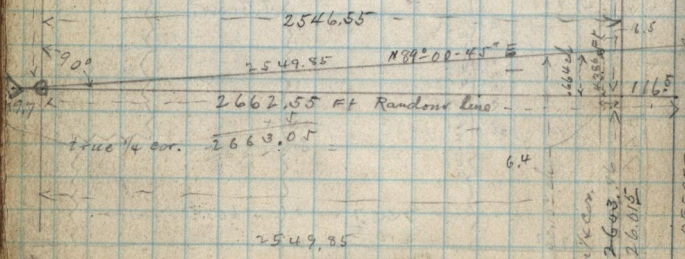

2549.85

OFFSET