


Center of Main Street in Ogden City.
N 0° 58' E

County Monument
No 48

19° 57' W to Ben Lomond, T.K.
U.S. Coast & Geod.
Survey Office
(by letter)



Center of Main Street in Huntsville
Co. Mt.

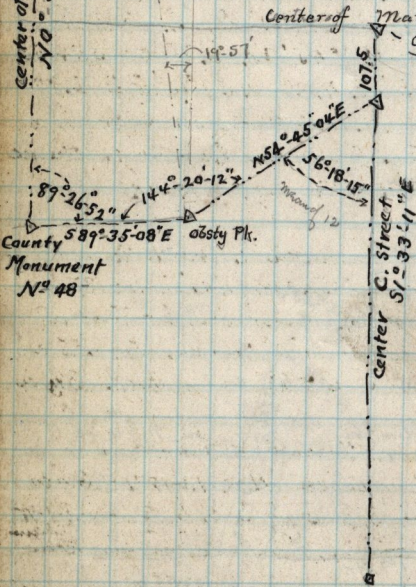

U.S. Coast & Geod. Survey Office