



Section 1 - 1/4 in the E.

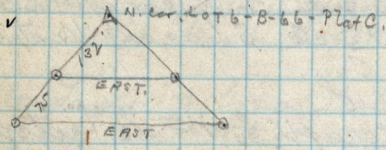

July 13 - 1889

Pt N.W. 1/4 Sec 16 T-6-N-R-1-W,

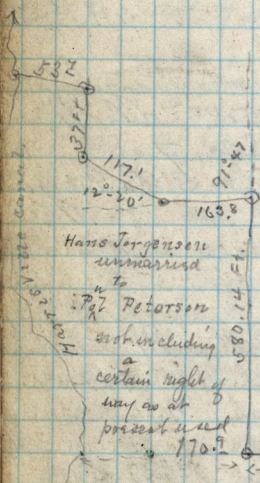

Hans Jorgensen
unmarried
to
Peterson
not including
a
certain right of
way as at
present used
is 170.7

Hans Jorgensen

400 FT. →