360
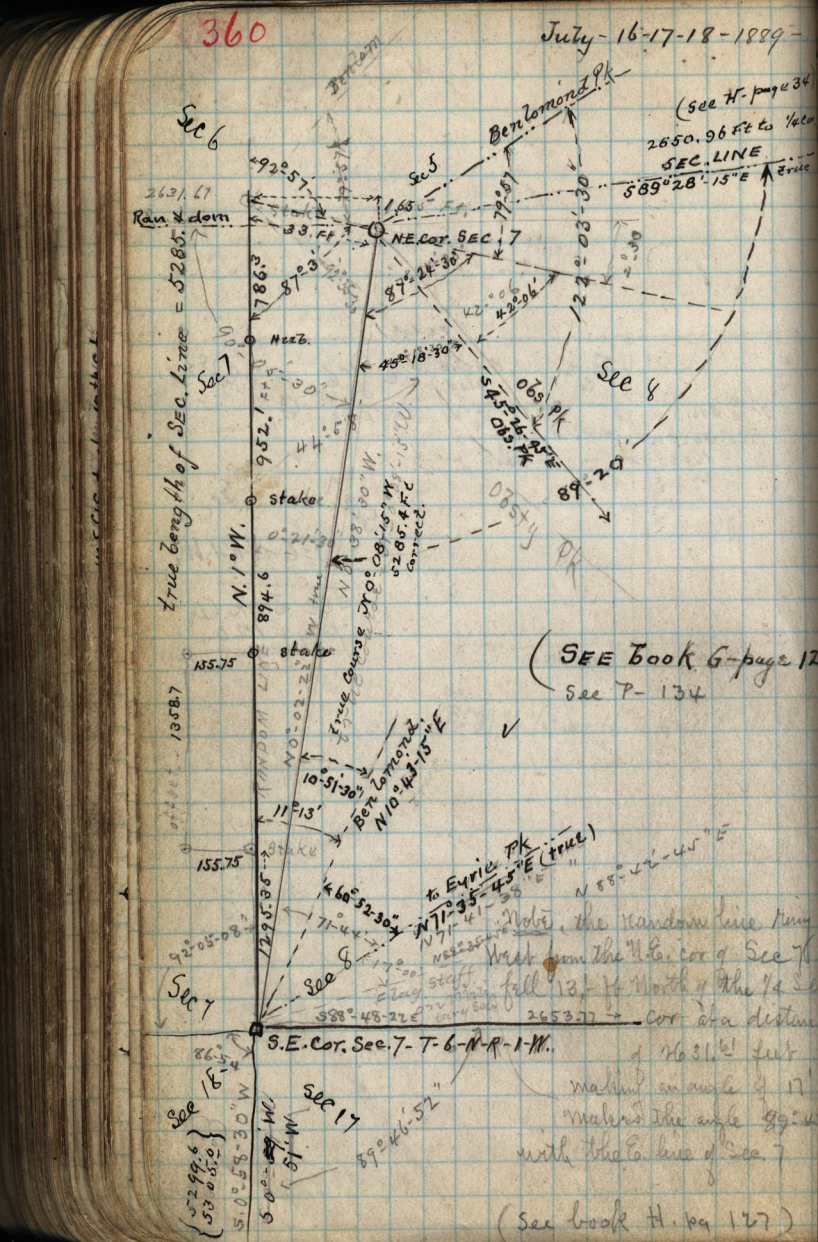
July-16-17-18-1889-