


see 6

see 5

N. E. Cor. SEC. 7-

see 7

see 8

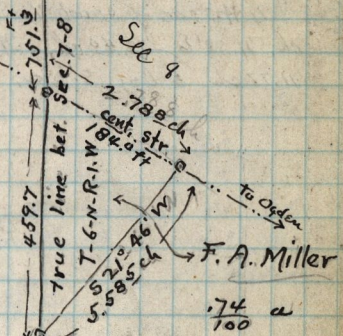

(see page 360)

