
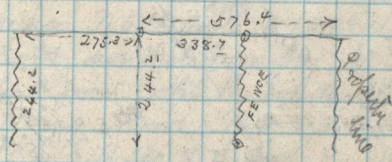


8292 367
 8292
 912.12

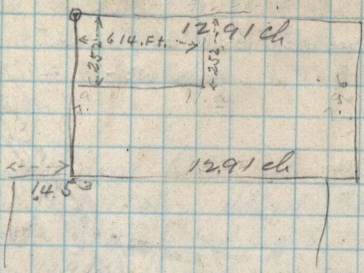

Aug 8-1889
 Survey
 N. 1/4 Sec. 9 T-5-N.
 R-1-W.
 For W. JENNY.