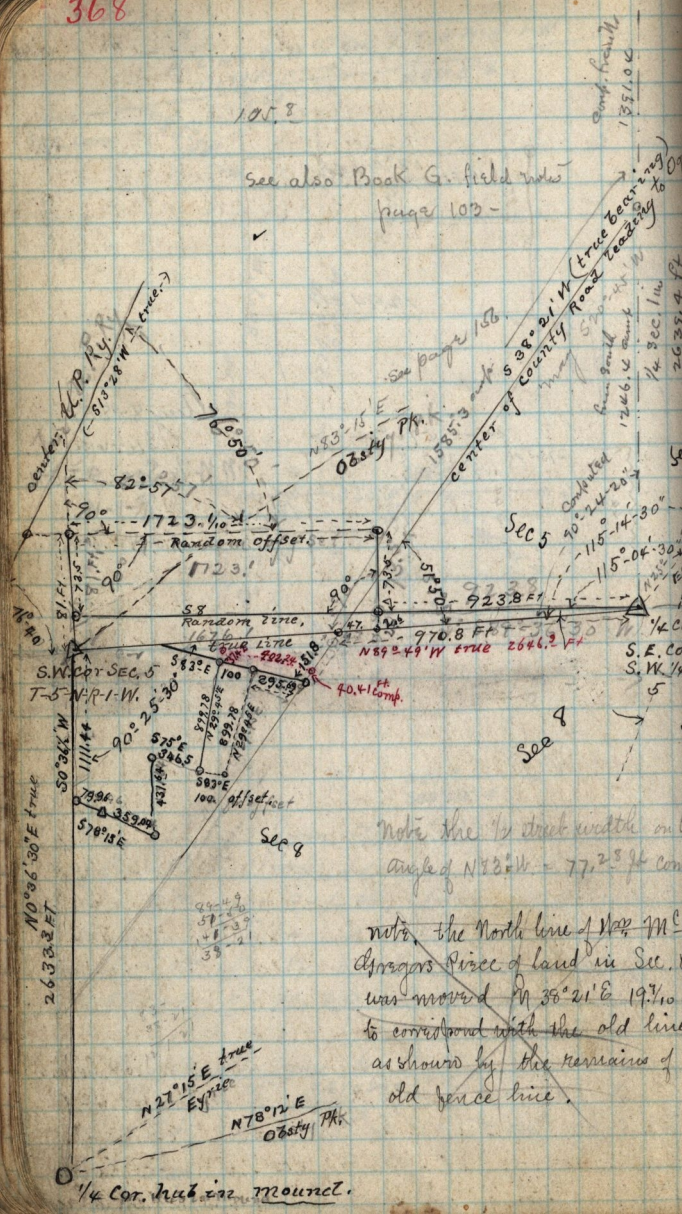
See also Book G. field notes page 103.
N 82°-57' E
90°
1723.1/10 Ft.
Random offset.
1723.1'
90°
81 Ft.
N 7°-40' E
S.W. Cor Sec. 5 T-5-N.R-1-W.
S 83° E 100
S 75° E 265
S 83° E 100 offset
S 78°-15' E
359 mks
N 0°-36'-30" E true 2633.2 FT
N 27°-15' E True
N 78°-12' E
Obsty Pk.
Obsty Pk.
N 83° 15' E
1585.3 mks
S 38°-21' W (true bearing)
center of County Road traveled
Sec 5
90°-24'-20"
115°-14'-30"
115°-04'-30"
923.8 Ft
970.8 Ft
N 89°-49' W true 2646.2 Ft
Random line, true line
S 8
S.E. Cor
S.W. 1/4
5
See page 158
Sec 8
See
Note the 1/2 street width on
angle of N 23° W - 77.23 ft Co
was moved N 38°-21' E 19.7/10
to coincident with the old line
as shown by the remains of
old fence line.