


A. J. CROPSEY'S 2ND ADDITION
TO
OGDEN CITY.

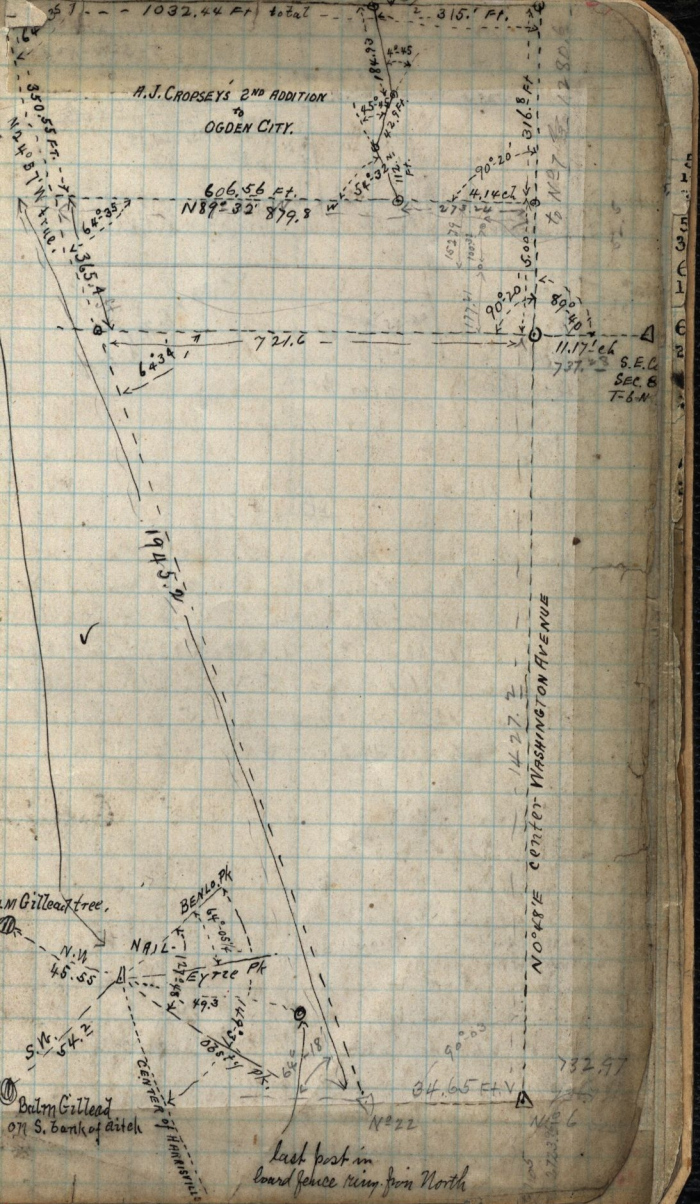

last post in
board fence lying from North

M Gillean tree.

Balm Gillean
on S. bank of ditch


