


(2)

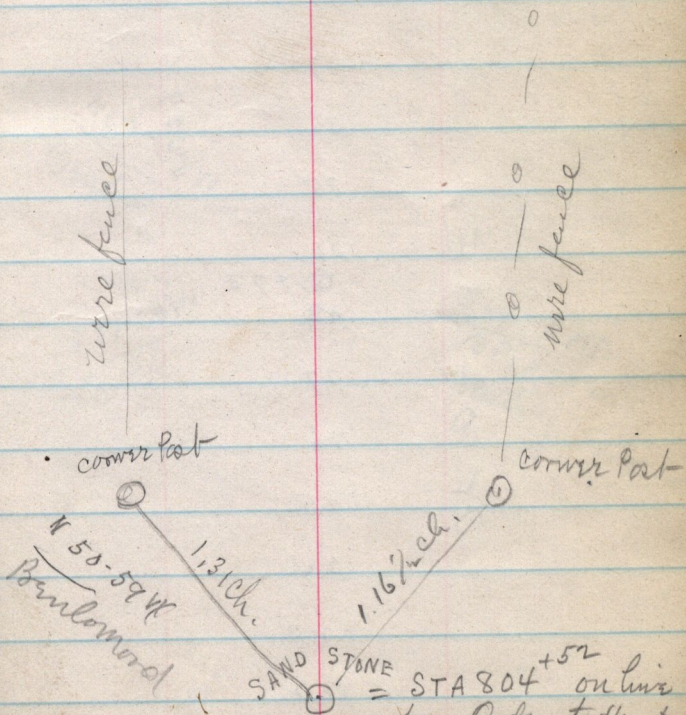

71291

STA 804 +52 on line from Ogden to Huntsville SEE BOOK E PAGE 58