


26

RHODES



$N 18^{\circ} - 01' W$
area on summit
Co. line

$N 35^{\circ} - 35' W$
pyramid tree
on Co. line

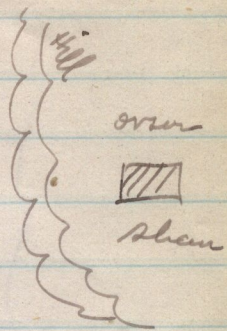

① + 93 = 20, CH. EAST.
122 FROM N.W. COR. SEC.
20 T. 7 N. R. 1 E.