


39)

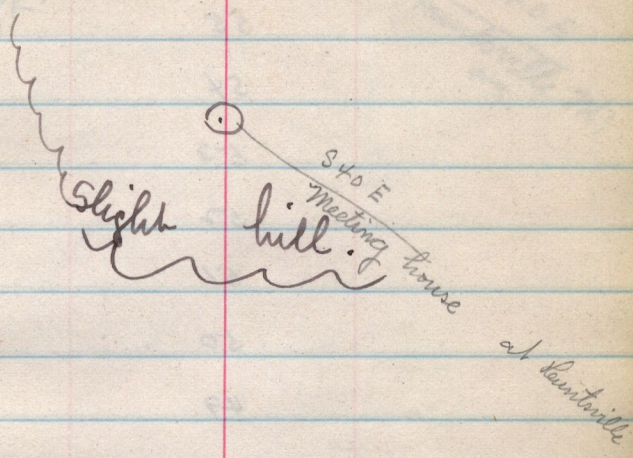

Magnetic Variation  
N 17° E.

4 Road Street  
center line

S 43-41 E  
Meeting house.

No 100  
STA 271. SEE Pg.  
(11)