


Township 5 North

Range 1 - WEST - Salt Lake Me.

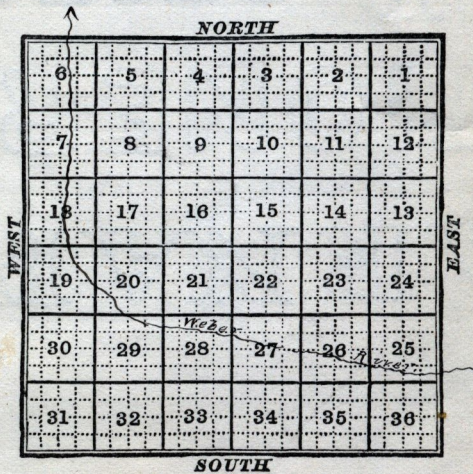

— Over. —