


Township 6 North

Range 3. West, Salt Lake Me.

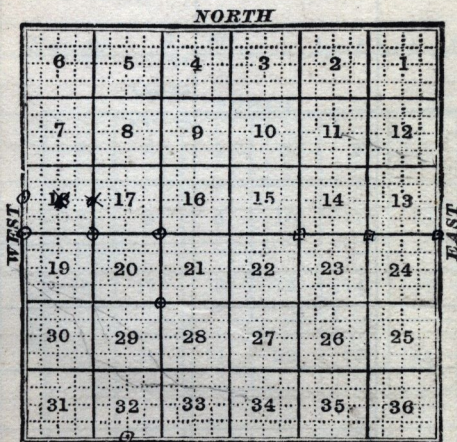

6 5 4 3 2 1

L
N
P
S
T