


6

10
SEC. COR.

Oct. 3-1889

SEC. 34 T-7-N-R-2-W.

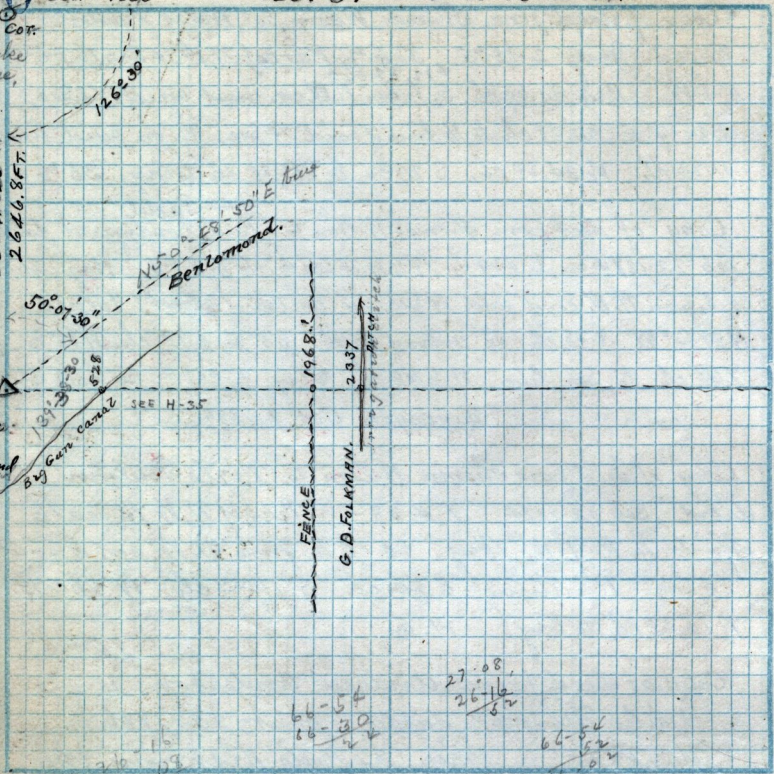

2 x 4 - stake
main fence,

true
50° 41' 20" N
2646.8 FT

126° 39'


50° 07' 30"

FENCE 1968.1

G. D. FOLKMAN 2.037

1/4 cor. Δ
Red Pine
Stake 1'
along ground

51° 33'
528
canal

SEE H-35

66-54
66-30
24

27-08
26-16
12

66-54
66-52
2

Scale: Chains per inch.

3/4 each lot

Copy of deed from David Jenkins to Millard Scowcroft dated March 27-1879 Z-518- Part of Lot 4 - in B-12 - Plat "A" Ogden City Survey. Beg. S.E. cor. said lot N 110. feet more or less W 45 feet S 110. ft more or less, E 45. feet to beg. reserve water ditch along south side.

Copy of deed from David Jenkins to Joseph Scowcroft dated Feb 6-1889 - N 341 - Part of Lot 3 - B-12 - Plat A Ogden City Survey. Beg. 77. ft. N. from S.E. cor. said lot N 55 feet N 99. feet E 55. feet S 99. ft to beg. reserve the water ditch along south end.