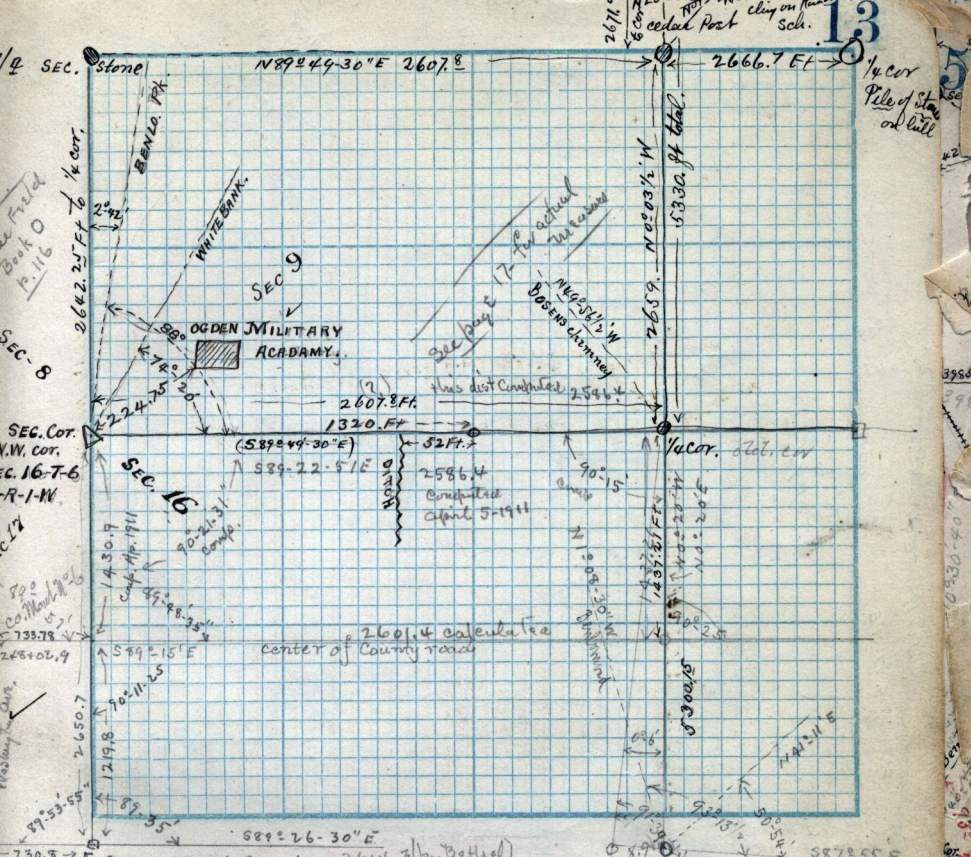

¼ S.E.¼ Sec 17 T-6-N-R-1-W.

Copy of deed from F.A. Miller to John M. Rostan, Pt. S.E.¼ Sec 17, T-6-N-R-1-W. Beg. 51 Rods N. from S.E. cor. W. 40. R. W 16. R. E. & S to Beg. to Robert Shaw, Beg. S.W. cor. N 5 R. W 40 R. S. & E to beg. to Francis Shaw, Beg. 48 R. W. & 69 R. 12 R. N. S. from N.E. cor. W 30. R. S 10 R. E & N to beg. also Beg. 48 R. W. and 42 R. N. from S.E. cor. W 20 R. N 12 R. E. & S to beg. Jos. Harrop. Beg. N.E. cor. W 40 Rods S 17. Rods E & N to beg. James Barker, Beg. S.W. cor. N 46½ R. E 31½ R. S & W to beg. Jas. Taylor. Beg. 5 R. N. from S.E. cor. W 40 R. N 22 R. E & S to beg. John Folkner. Beg. 46½ R. N. of S.W. cor. N 36½ R. E 51 R. S 20 R. W 19½ R. S 16½ R. W 31½ R. to beg. corrected by new deed) Jas. Walker, Beg 51 R. N. of S.E. cor. W 40 R. S 4 R E & N to beg. — Nahum Porter, Beg. N.W. cor. S .65 ch. E 5.33 ch. N 1¼° W. 1.95 ch. S 89¼° E 23.42 ch. N 2.54 ch. W 89° N. 11.03 ch N 1° E 6.26 ch N 68¼° W — N 3° E 7.12 ch. W 13.87 ch. to beg. Chas. McGary. Beg. 44 R. N. of S.E. cor. N 46 R 3 ft. W 24 R. 12 R. E 24 R. N 10 R 5. feet W 84 R. S 68 R 8. ft. E 84 R to beg. F.A. Miller to Geo. Rumriell. I-94

Beg. 25.40 ch E. of N.W. cor. S 7½° W 2.30 chs. N 89¼° E 5.26 chs. N. 2.25 chs W. 5.08 chs to beg. 1.16 a

F.A. Miller to Anna Cordon. H-17. Beg. 13.87 ch. E. of N.W. cor. S 3° W. 7.10 ch S 68¼° E 4.71 ch. S 1° W. 6.26 ch S 89° E. 11.03 N 12.46 ch. S 89¼° W. 5.26 ch. N 7½° E 2.30 ch. to Sec. line W 9.86 ch. to beg.