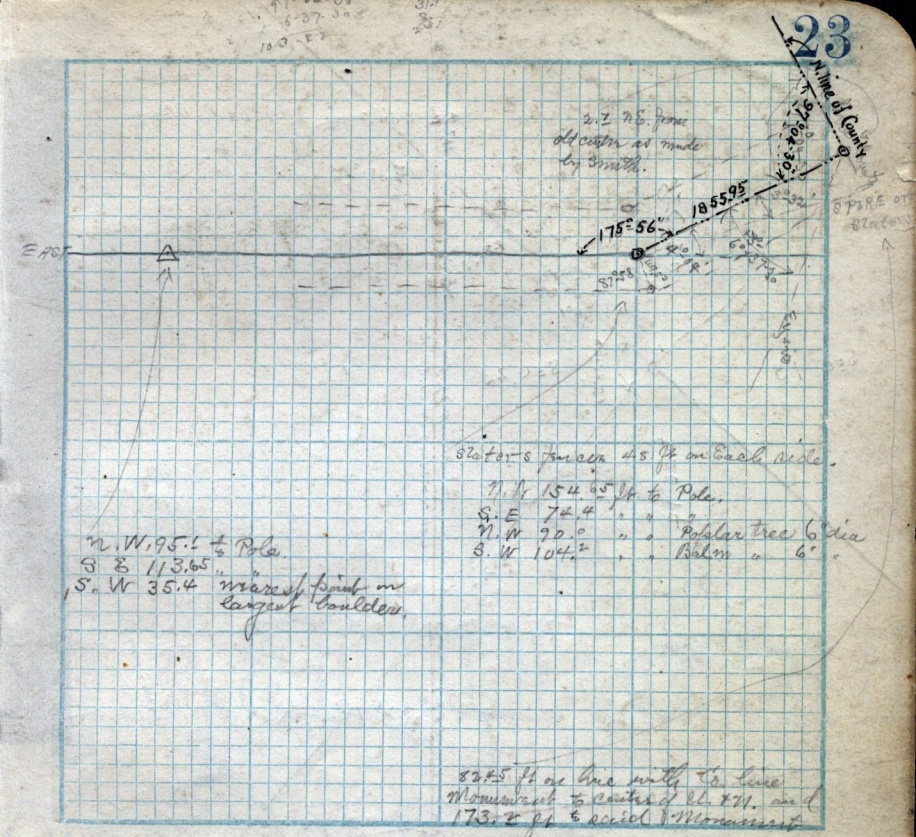

Scale: Chains per inch.

✓

From center U & N to center C.P. = 1048.45 due West.

The S.E. angle made by the intersection of the County line and the C.P. Ry = 70°59'-15"

The N.W. angle made by the intersection of center Co. Road and the S. line Sec. 14 T.7.N.R.2.W = 41°-28'

dist from S. line Sec 14 along cent St to Co line 558.9