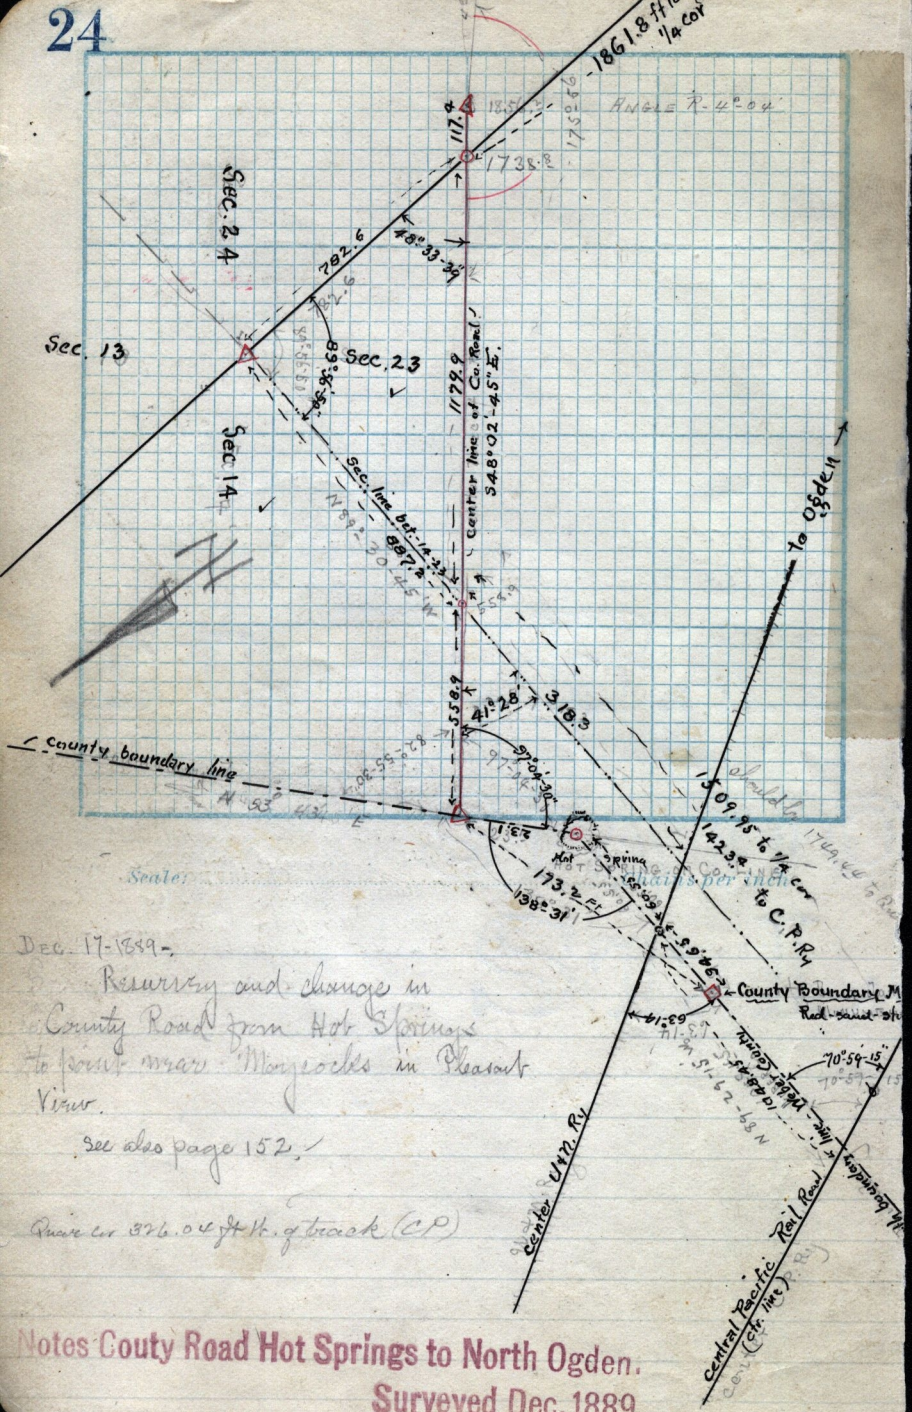

Scale:

Dec. 17-1889.-

Resurvey and change in County Road from Hot Springs to point near Mongcocks in Pleasant View.

see also page 152.

Quarter cor 376.04 ft N. of track (C.P.)

Notes Couty Road Hot Springs to North Ogden.
Surveyed Dec. 1889.