


in Sec 24
n. w. 1/4 ✓

Scale:

Chains per inch.

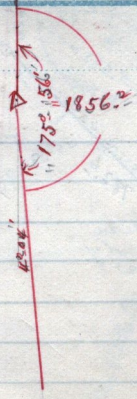

DEC, 18-1889-

Resurvey of center line
of County Road from Hot Springs
to North Ogden, with Sec. line
Corrections