


JAMES JENSEN.

COUNTY ROAD to POLE Patch.

MAYCOCK

T. 7-N-R-1-W
T. 7-N-R-2-W
MAYCOCK.

Edwin Humphreys

Maycock Estate.


RHEESE

RHEESE

Scale:

Chains per inch.

MONUMENT OVERLOOKED
SEE FOR TURN IN
SE400.

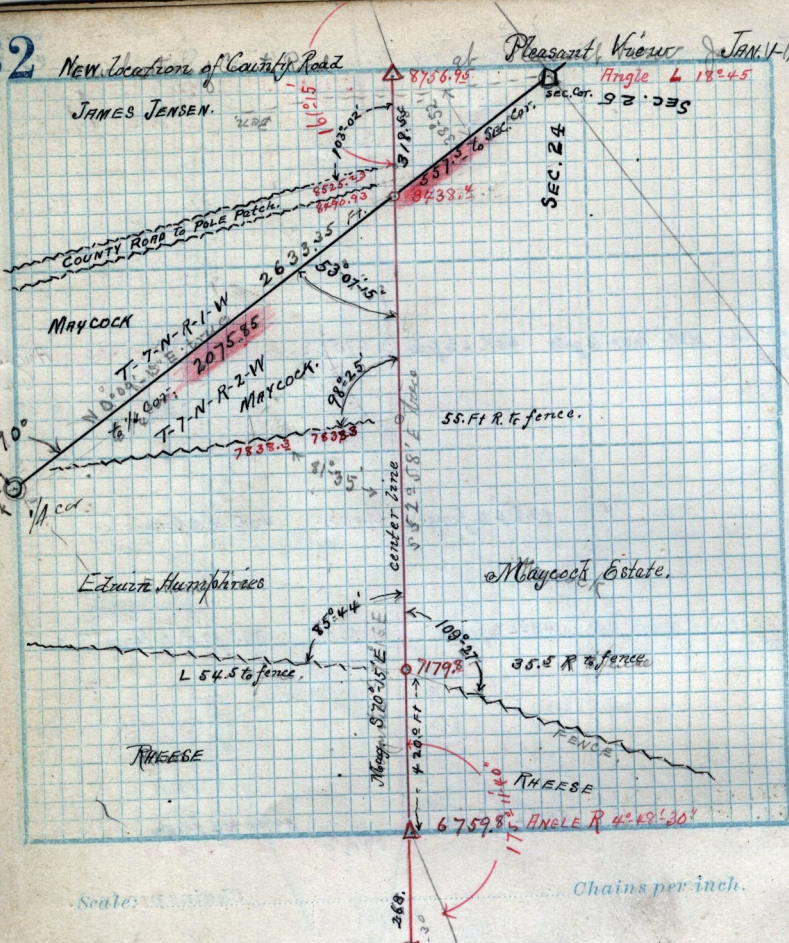

54 39 14
78 38 3
60 81