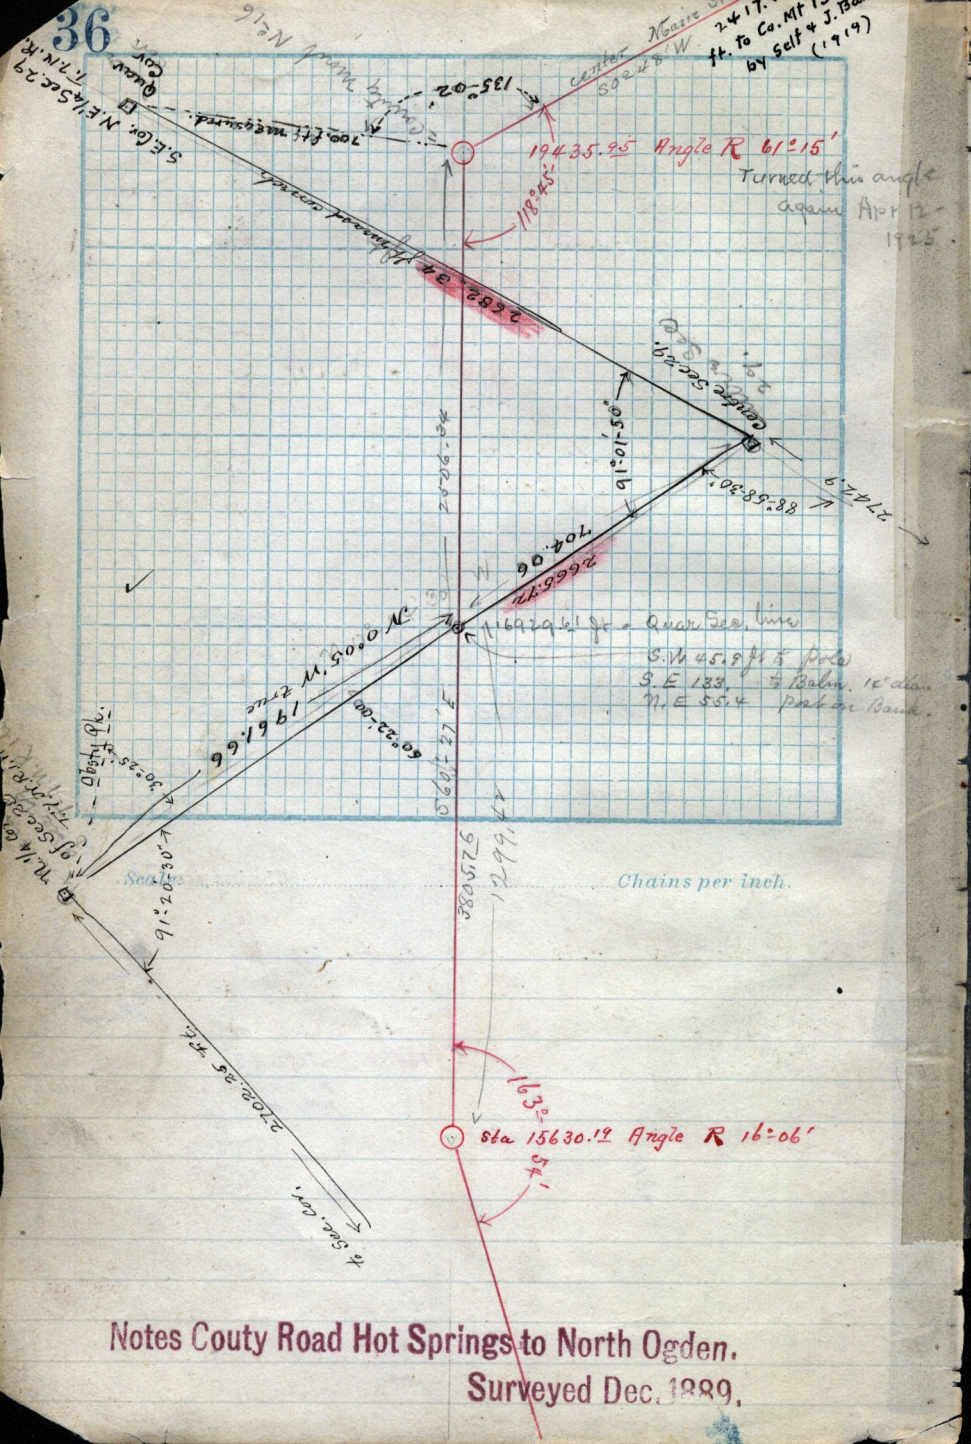

Notes Couty Road Hot Springs to North Ogden.
Surveyed Dec. 1889.