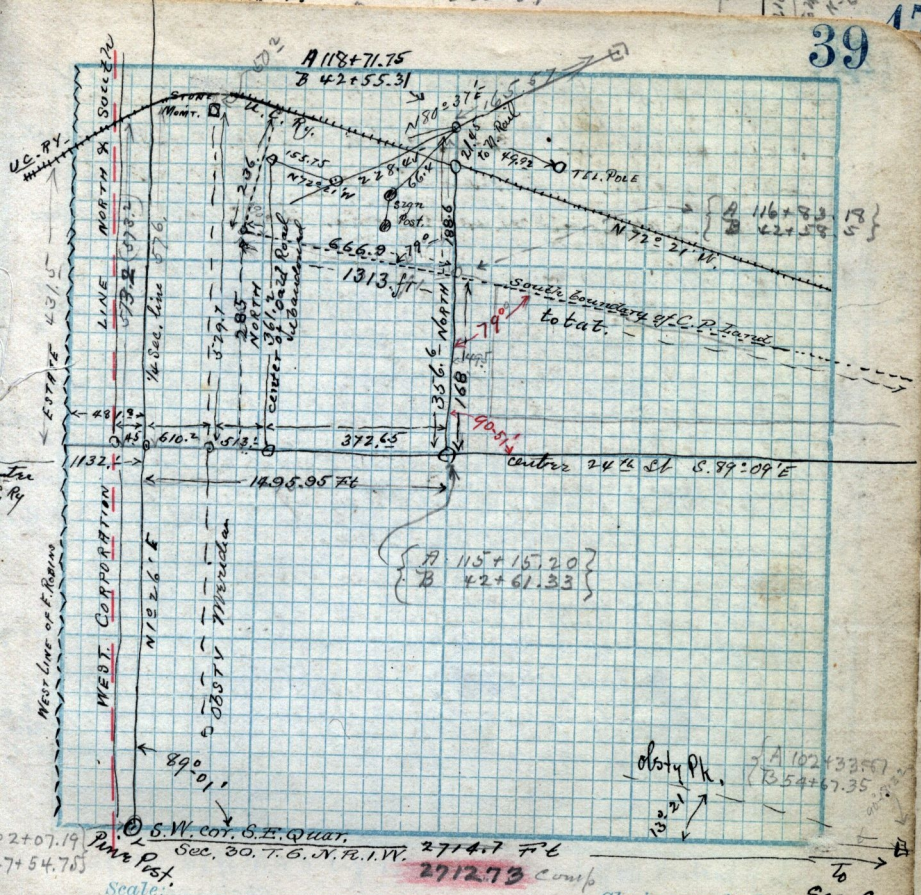

M. Cole to Geo. H. Mewell W. 291. Pt N. E 1/4 Sec 5 T-5-N-R-1-W
Beg. 20.88 ch W. from W. side Main Street and S. line Co. Road. S 3.88 ch
2.52 ch N. & W. to beg.

nves Burch to C. M. Cole. W. 351. Pt N. E 1/4 Sec 5 T-5-N-R-1-W,
g. 15.01 ch W. of State Road on N. side of what is known as Co. Road
7.65 W 6.87 ch N 7.65 ch E along E. side Road 6.87 ch to beg.
Deed from James Burch to John Shupe, May 30-1870- K-118-
N.E 1/4 Sec. 5 Sp. 5 N.R.1-W. Beg. 12.80 ch. E. from N.W. cor. said 1/4 Sec. S. 8.65 ch,
.80 ch, N 8.65 ch, W 4.80 ch to beg.

✓ to here