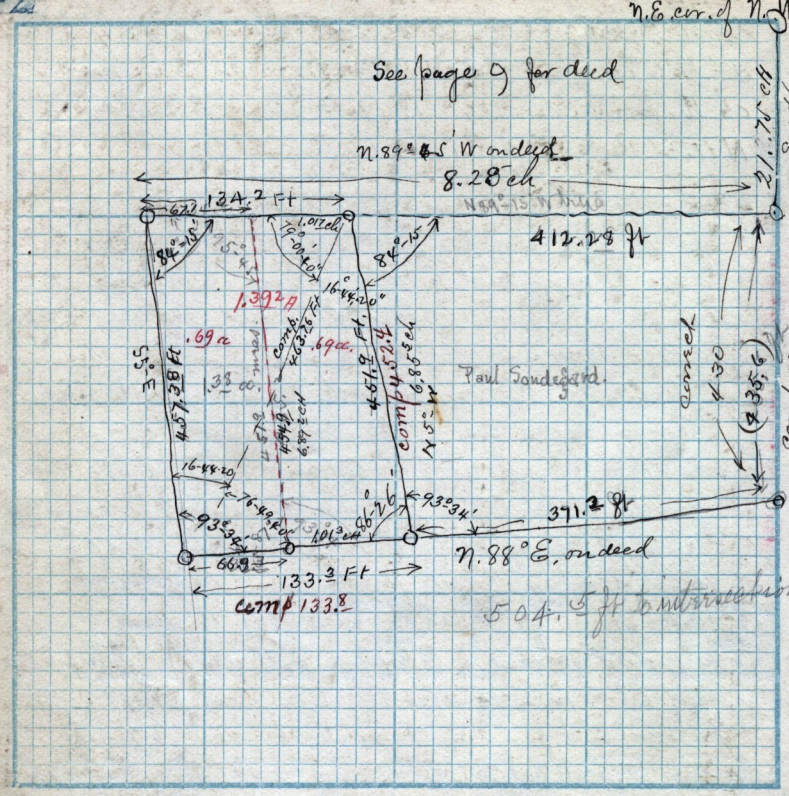

Scale: ..... Chains per inch.

Survey for Sondegaard Feb 11-1890

Part of Sec. 16 T6-N. R.1W.

Washington Jenkins
Co. Survey

{ A Rostan
{ E. Wheeler } chainmen