S.W. 1/4 Sec. 30 T-7-N-R-1-W.

FEB-12-1899 - Apr. 4th

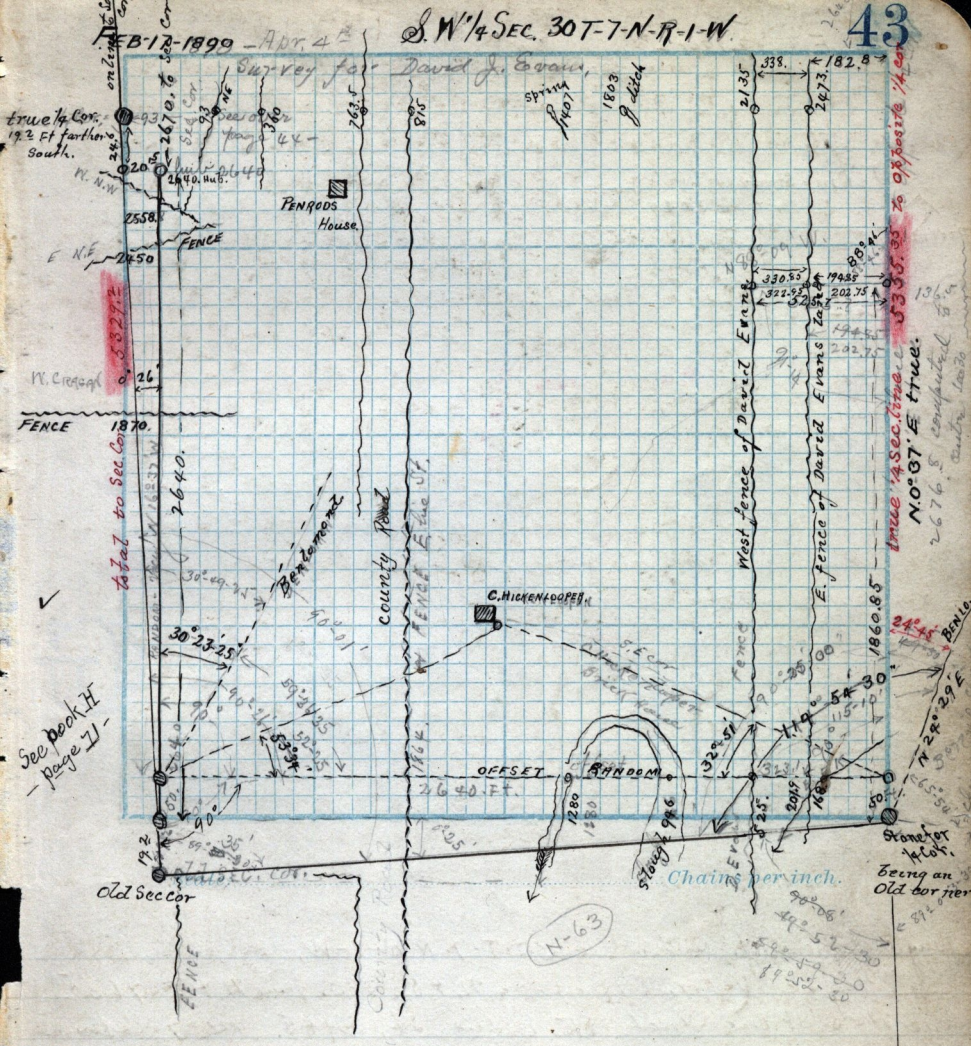

April 4th 1890 - Running South along 1/4 Sec. line, beginning at N.E. cor of N.W. 1/4 Sec 30 T-7-N-R-1-W. 1238 ft = center North Ogden Canal N.W. 1246 ft = fence N.W. 2640. hub & tack 3494.5 = hub & tack at line of property, to be conveyed by D. Evans 4311. ditch S.W. 5253 drain S.W. 5355.35 old 1/4 Sec. cor. known as horse head cor.

W. Jenkins transit Al Rostan and — Hickenlooper chainman

done for David Evans

5424.35 ft S to 1/4 Sec. cor.