


Mar. 3-1890

Survey for C. Elworth
270 West Weber.

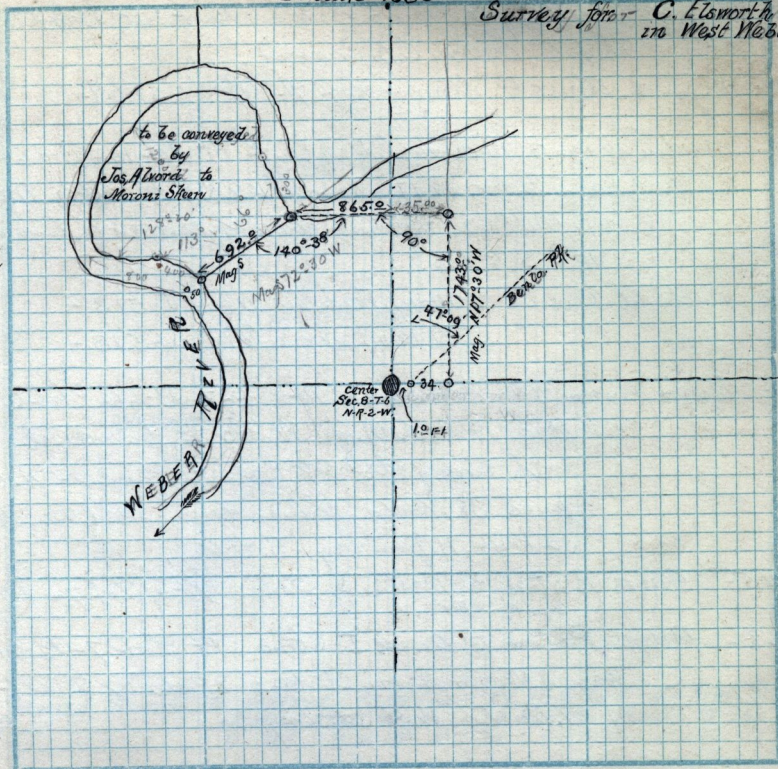

Scale: Chains per inch.

Survey Made by F. Srematop
E. Wheeler & C. Poston } Chain