I-253- Mayor to Merlin J. Jones all of Lot 10- Block 66- Plat C Ogden City Survey

Q 432- Mayor to Amos P. Stone - Lot X- B-66 - Plat C.

J-513- Merlin Jones to Michael Wahlin ✓ Pt Lot 10 - B-66 - Beg S.E. cor. W 17½ Rods 288.75 ft N 49 R.E to center Mill Cr. up Mill Cr. to point where it crosses E. line of Lot 10 - S to beg.

U-352 Michael Wahlin to Mary Wahlin W½ of J-513 -

V-118 " " " Diana Farr, E½ J-513 -

L616- Amos P. Stone to Amos L. Stone - Pt of Lot 7- B-66- Plat C. Beg. 19 Rods N. of S.W cor. E. parallel with line of 22 Rods to fence - N. along fence 38 Rods thence down Mill Cr. to pt 32 Rods N. from beg. S. to beg.

M445- Amos P. Stone to Merlin J. Stone Pt of Lot 7- Beg N. to cor.
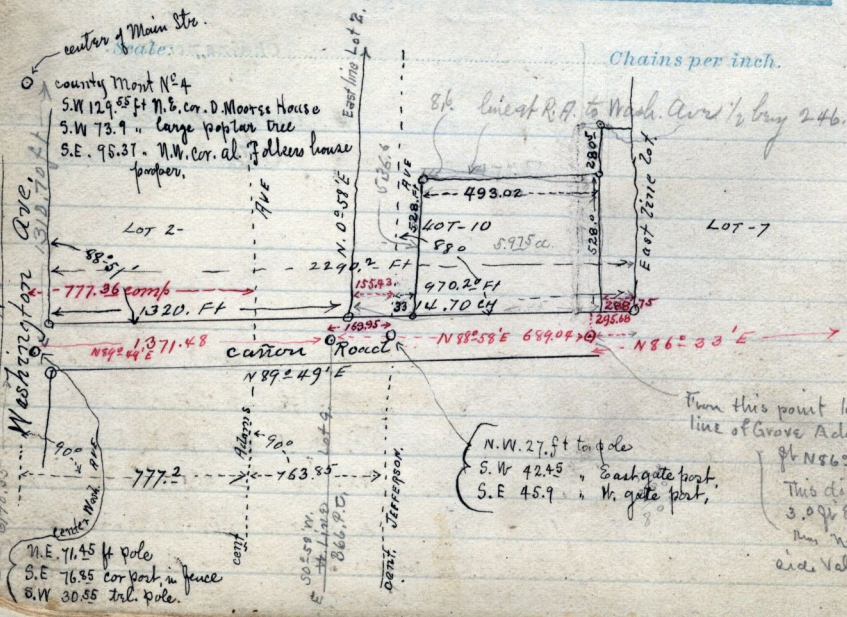
N 128- Amos P. Stone to Amos I. Stone Pt Lot 7- B-66 - Beg. S.W. cor. E. on St line 8 Rods N of 8 feet N 19 Rods W. & S to beg