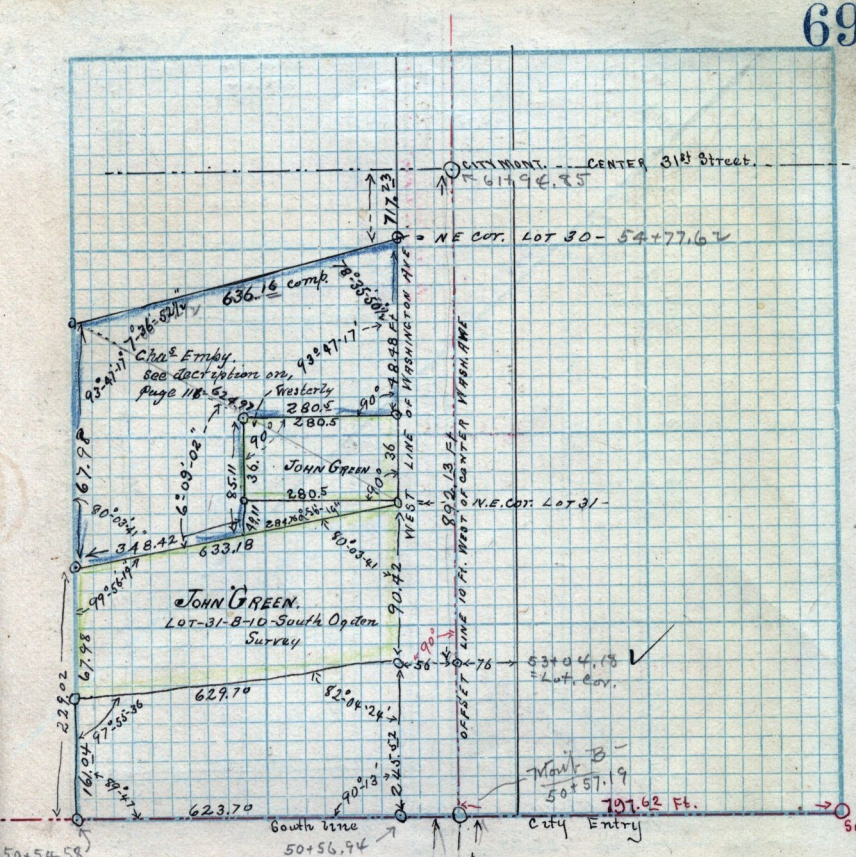

Survey for John Green
in Lot 31-30-B10-South Ogden Survey.

Mar. 11-12-1890

Courses from 24 5