70

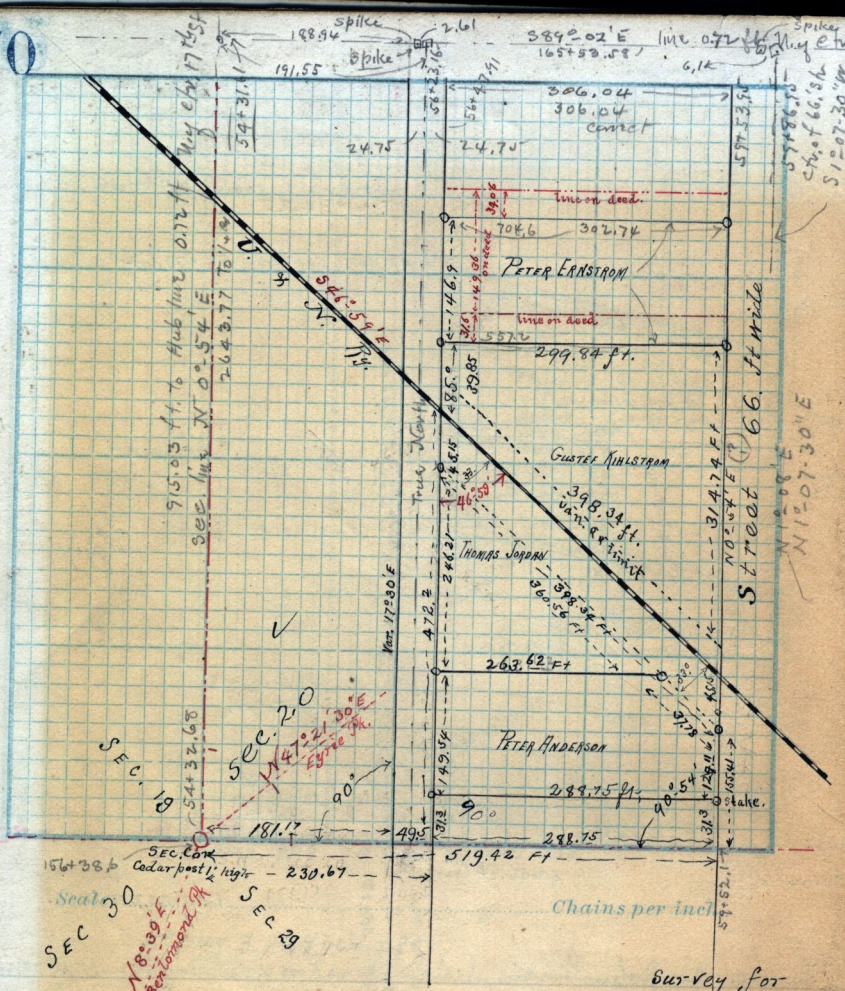

Survey for
Samuel Glasgow, in
Sections 20-19-2
T-6-1-W
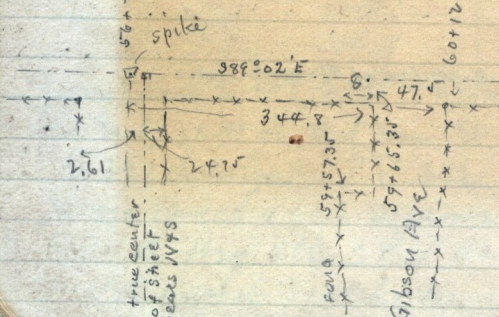
See also Book F. p.
" Plat " P.87