


5

84

Mar. 31st 1890


changed location of Co Road in Slater

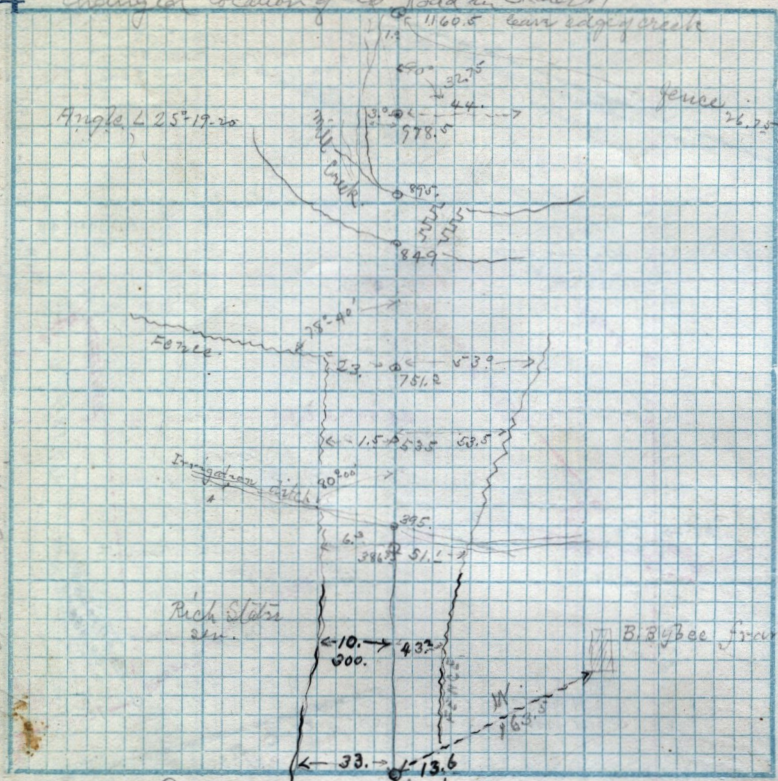

about S 70° W

fence 26.25 Right

B. B. Bee frame

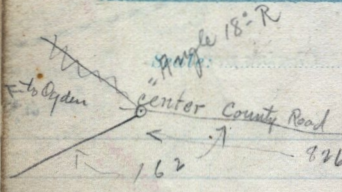

See also page 143
Chains per inch.

to Plain City.

4672 feet from the point
at H. Brown's Cor.