


See Field Book T. pg. 368 -  
 " " " " " 81 -  
 N 89° 49' W 2646.9

NE. cor.  
 N.W. 1/4  
 Sec. 8  
 T. 5. N. R. 1  
 W

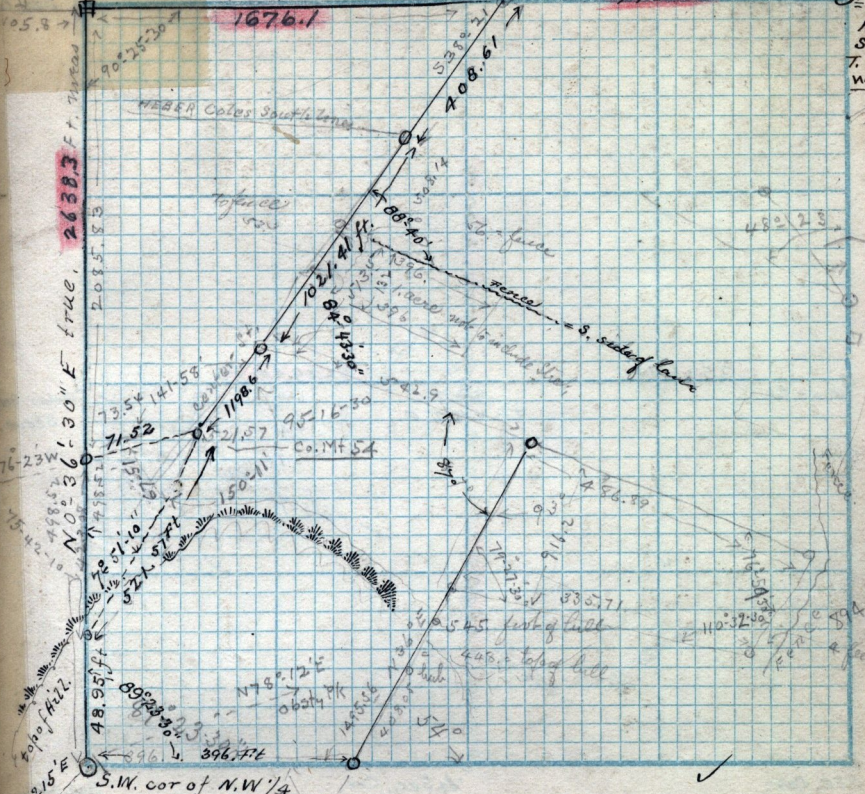

N 0° 36' 30" E true, 2638.3 F. true  
 N 27° 15' E  
 S.W. cor of N.W. 1/4  
 Sec. 8-T-5-N-R-1-W  
 Scale:  
April 16-1890

Chains per inch.

W. Jenkins transit.

A. Rastan, Lead, by Hyrum Hubbard kind chairman  
 Fred Stone flagman.

Copy of deed from Edward Stratton to Robert + Mc Gloy, Nov. 7-  
 1879, - M-346, Pt. N.W. 1/4 Sec. 8-T-5-N-R-1-W, Beg. 15.87 ch. S. 34  
 15.37 ch. W. of N.E. cor. said 1/4 Sec, S 40° W. 7.92 ch, N 57° W  
 9.04 ch. to center of Tex. road, thence to center of said road  
 N 38 1/4° E 7.92 ch, S 57° E 9.30 ch. to beg. 7.21 a.

Mar 24-1918 Traverse Table - Beg. at N.W. cor. Sec. 8 - T. 5. N. R. 1. W

	N	S	E	W		
1676.1	589.49 E	5.36	1676.1		to ctr. Co. Road	
2620.6	535-21 W	2061.40		1631.0	along ctr. to Mont. & Co.	
735.54	576-23 W	17.31		71.47	to Sec. line	
2085.83	N 0° 36' 30" E	2085.7		22.14	along Sec. line	
		2085.7	2084.07	1698.24	1702.47	