April 20 - 1890 - Survey of land for Robert Aldoes & for Alanson D. Allen.

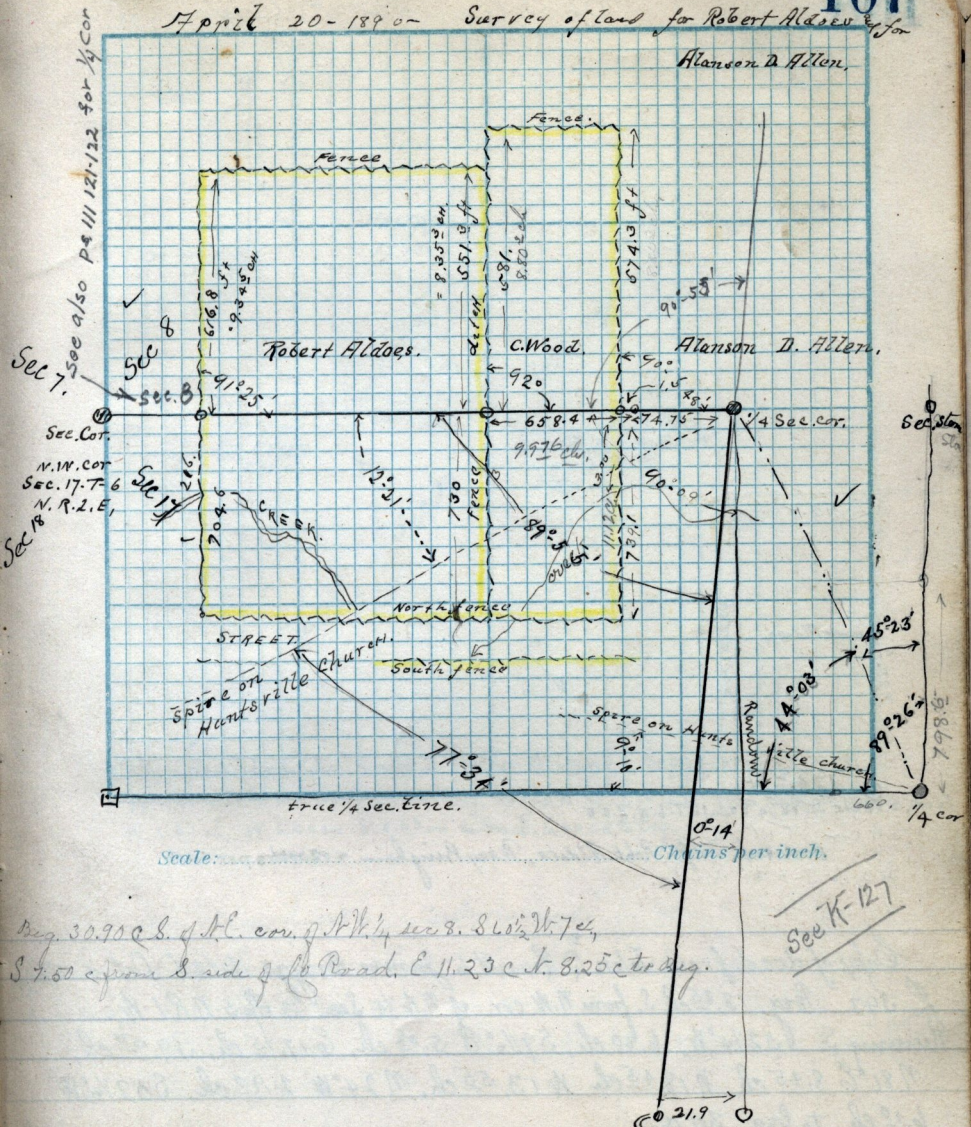

Scale: ..... Chains per inch.

See K-127

Beg. 30.90 c S. of N.E. cor. of N.W. 1/4 sec 8. S 60½ W. 7 c.,
S 7.50 c from S. side of Co Road. E 11.23 c N. 8.25 c to Beg.