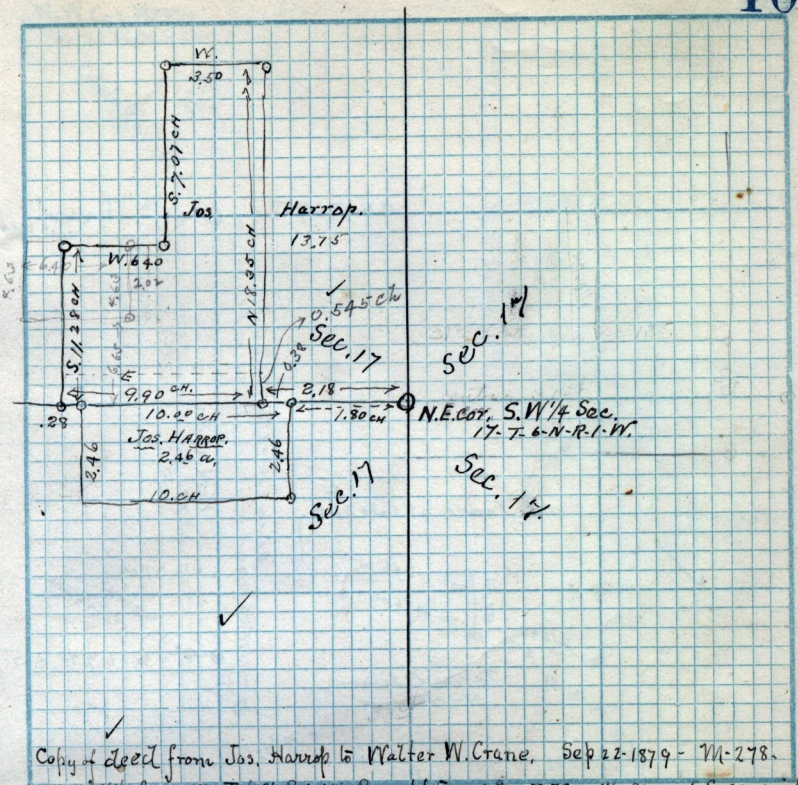

Copy of Deed from Jos. Harrop to Walter W. Crane, Sep 22-1879 - M-278.
Pt N.W 1/4 Sec. 17-T-6-N-R-1-W. Beg. 6.65 ch N. & 7.70 ch W. from S.E. cor said 1/4
N. 4.63 ch, W. 6.40 ch S. 4.63 ch to beg. E. 6.40 ch to beg.

Scale: ..... Chains per inch.

May-16-1890 - Survey made for John R. Potter.

Copy of deed from Samuel Gates to Joseph Harrop. June 29-1872
L-427 Pt N.W 1/4 Sec 17-T-6-N-R-1-W. Beg. 2.18 ch W. from
S.E. cor. said 1/4 Sec. N 18.35 ch W 3.50 ch. S 7.07 ch W 6.40 ch
S 11.28 ch E 10. ch to beg. 13.70 a

Copy of deed from Erastus Bingham to Joseph Harrop - Sept. 1
1874 - L-422, Pt S.W 1/4 Sec 17-T-6-N-R-1-W, Beg. 1.80
ch. W. of NE. cor. of said 1/4 Sec, S. 2.46 ch W 10. ch N 2.46 ch
E 10. ch to beg. 2.46 a.

Copy of Deed from James H. Stone to Walter W. Crane dated Sept 22-1879
M. 277 - Pt N.W 1/4 Sec. 17-T-6-N-R-1-W. Beg. 18.35 ch. N. & 7.70 ch W of S.E. cor. sd 1/4
S 7.07 ch. W. 5.25 ch N. 7.07 ch. E 5.25 ch to beg. 3.1/2 a