April 29th 1890

See description on page 105.

Survey made for Wallace Foulger

W. ½ of Lot 9-B-4 Plat A

Ogden City

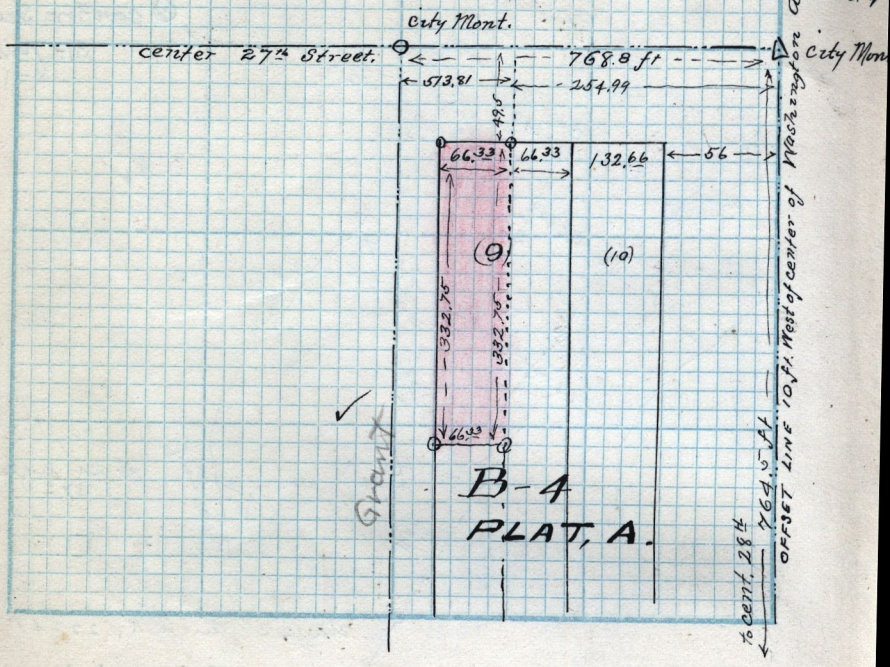

Scale: ..... Chains per inch.

Computations made from an Abstract, furnished by Dand Farr.

Pt. S.E¼ Sec 21, Sp. T. N. R. 1 W. beg. S.W. cor. said ¼ Sec. N 6.65 ch. S 78° E 6.98 ch S 88½° E 7.18 ch, N 30° W 10. ch S 57° W 10.88 ch N 15.00 ch E 0.05 of 1 ch N 13.60 ch N.E. in straight line to a point 3.15 ch due East of N.W. cor said ¼ E 28.60 ch, S 6.75 ch, S 25¾° E 4.17 ch, S 59° E 8.00 ch S 1.25 ch, W 1.30 ch, S 5¼° W 26.32 ch W 27.25 ch to beg.

Copy of deed from E. H. Ohlson to Charles Empy dated March 19-1879- M128- Pt Lot 30-B-10-S.O.S. Beg. at N.E. cor. said Lot, thence Southerly 48½ feet more or less along W. line thence Westerly 7.7 Rods Southerly 36¾ feet Westerly to S.W. cor, said Lot Northerly 84½ (?) more or less. to N.W. cor. of said Lot, thence Eastwly to beg. See sketch page 69.

Sec 5 - 30 - 1 W